Authorization to Construct - (11:30) -

IREDELL COUNTY HEALTH DEPARTMENT

STATESVILLE 704-878-5305 MOORESVILLE 704-664-5281

IMPROVEMENT PERMIT / ~~CERTIFICATE OF COMPLETION~~ / OPERATION PERMIT / EXISTING SYSTEM INSPECTION

PROPERTY DESCRIPTION NO. 21966 DATE 1/6/97 TAX MAP NO. 2B5 B2 4644 09 3163 Watershed: [X] Yes [ ] No

OWNER OR CONTRACTOR Wayne Elliott PHONE: Business _____ Home 872-0192

ADDRESS PO Box 36 Davidson, NC 28036

LOCATION Knoxview Ln. - Lengthen Rd TL 1st Knoxview to 2nd lot on (R) on new street

SUBDIVISION Kings Landing BLOCK / SECTION _____ LOT 2 LOT AREA .92 Ac SITE CLASS PS DESIGN FLOW 480 L.T.A.R. .325

Septic Tank: 1000 Gallons; STB 794 Date 8/15/97

Pump Tank: 1000 Gallons; PT 27 Date 6/15/97

Pump Make: HYDROMATIC Model 85S150 Serial No. 370*

Nitrification Field: No Fields 1 Square Feet 1476 Linear Feet ~~495~~

No Lines 5 Trench Width 36" Max Trench Bottom Depth 30" Gravel Depth SAND

[X] New System [ ] Repair System Type: I, II, (III) IV, V, VI

System Description: Pressure Manifold-Cit Plastic

Repair System Description: Same

Maintenance Agreement Required: [ ] Yes [X] No

[X] House/Mod. Home No. Bedrooms 4

[ ] Mobile Home No. Bathrooms 3

[ ] Business No. Employees _____

[ ] Other _____


[ ] Slab [X] Crawl Space [ ] Basement w/plumbing [ ] Basement wo/plumbing

Water Supply: [ ] Individual [X] Community [ ] Public


Comments:

Comments: 4 NEW PRESSURE TANKS

INITIAL SITE SKETCH

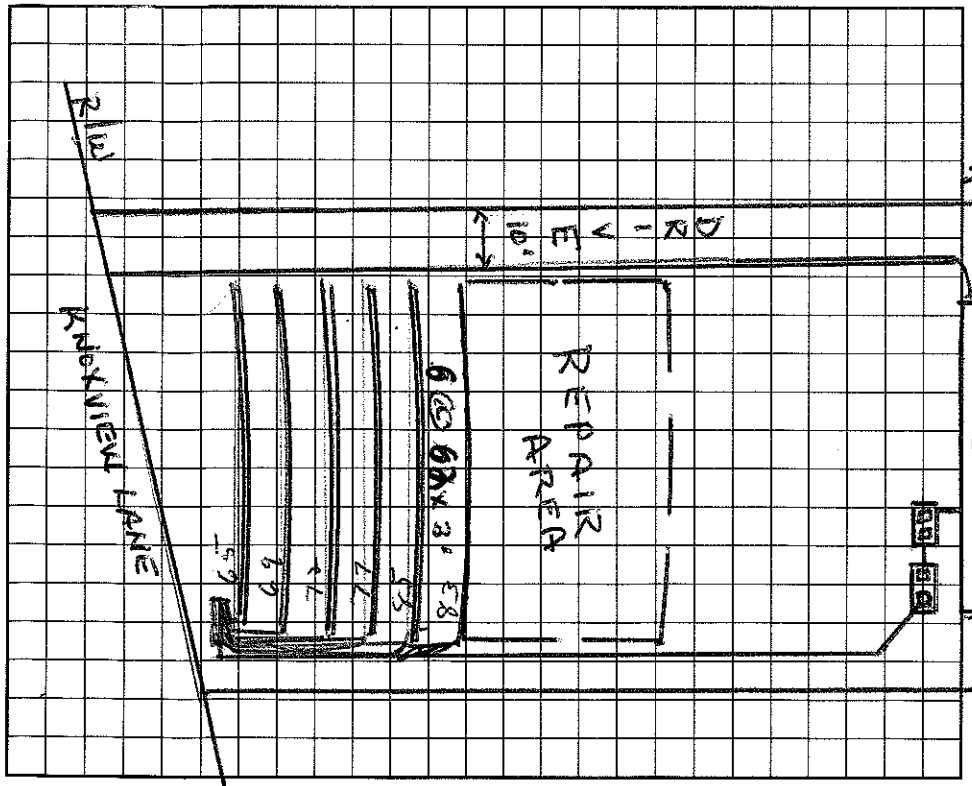

AS BUILT SKETCH

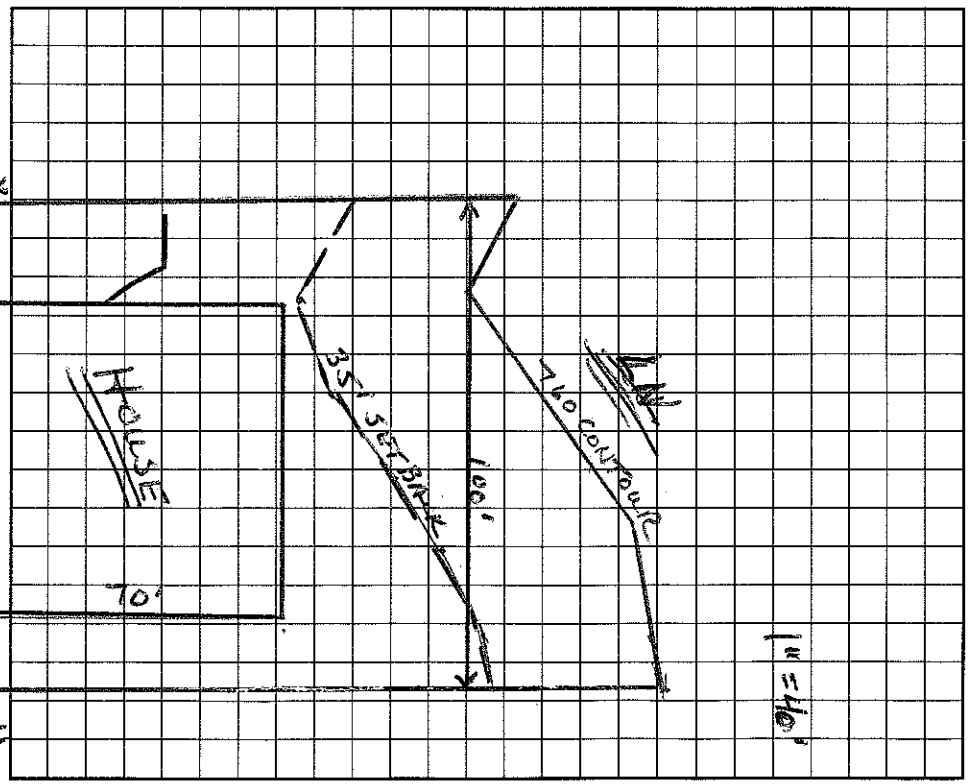

I understand that this permit can be suspended or revoked if any false information is supplied toward securing the permit/any unauthorized changes are made to the site/any unauthorized changes are made in the installation of the system. Improvement Permit is valid for 60 months from date of issuance.

Signed: Wayne Elliott

Improvement Permit by: Wesley Sparks RS. date 1/7/97

Existing System Inspection by: Wesley Sparks RS. date 1/7/97

Installed by: TIM AMMONS

Certificate of Completion by: Wesley Sparks, R.S. date 3/16/98

Operation Permit by: Wesley Sparks RS date 3/16/98

Recd TC

HEALTH DEPT. COPY: WHITE INSPECTION COPY (FINAL): GREEN OWNER COPY (FINAL): YELLOW INSPECTION COPY (INITIAL): PINK OWNER COPY (INITIAL): GOLD