IREDELL COUNTY HEALTH DEPARTMENT

STATESVILLE 704-878-5305 MOORESVILLE 704-664-5281

IMPROVEMENT PERMIT / CERTIFICATE OF COMPLETION / OPERATION PERMIT / EXISTING SYSTEM INSPECTION

PROPERTY DESCRIPTION NO. 21079 DATE 5/19/95 TAX MAP NO. 2B 5A 1 4644 09 3233 Watershed: ☐ Yes ☒ No

OWNER OR CONTRACTOR Earl Ray Hiatt PHONE: Business _____ Home 483-1660

ADDRESS 7020 Vinewood Rd. Sparkly Ford, NC. 28673

LOCATION Knoxview LN (L) off Longtree at 2nd Bridgeport Entrance ~ .3 mile on (L)

SUBDIVISION Kings ~~Landings~~ BLOCK / SECTION _____ LOT 1 LOT AREA 1.61 AC SITE CLASS. P DESIGN FLOW 360 L.T.A.R. .3

Septic Tank: 1000 Gallons; STB 794 Date 1/26/95

Pump Tank: 1000 Gallons; PT 419 Date 3/2/96

Pump Make: _____ Model _____ Serial No. 400

Nitrification Field: No Fields 1 Square Feet 1200 Linear Feet ~~300~~ 360

No Lines 4 & 6 Trench Width 36" Max Trench Bottom Depth 32" Gravel Depth N/A

☒ New System ☐ Repair System Type: I, II, (III) IV, V, VI

System Description: Pressure - Infiltrator

Repair System Description: Same

Maintenance Agreement Required: ☒ Yes ☐ No

☒ House/Mod. Home No. Bedrooms 3

☐ Mobile Home No. Bathrooms 2

☐ Business No. Employees ____

☐ Other _____


☐ Slab ☒ Crawl Space ☐ Basement w/plumbing ☐ Basement wo/plumbing

Water Supply: ☐ Individual ☑ Community ☐ Public


Comments: * .25 reduction for Infiltrator use
Lines on slope contour in direction shown

Comments:

INITIAL SITE SKETCH

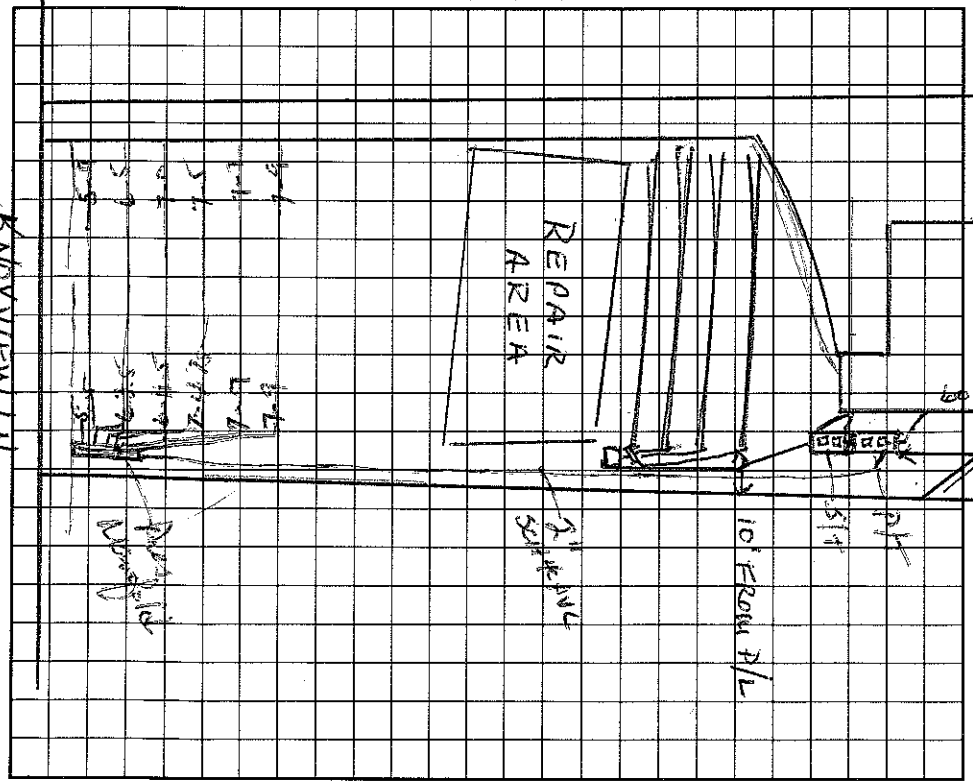

AS BUILT SKETCH

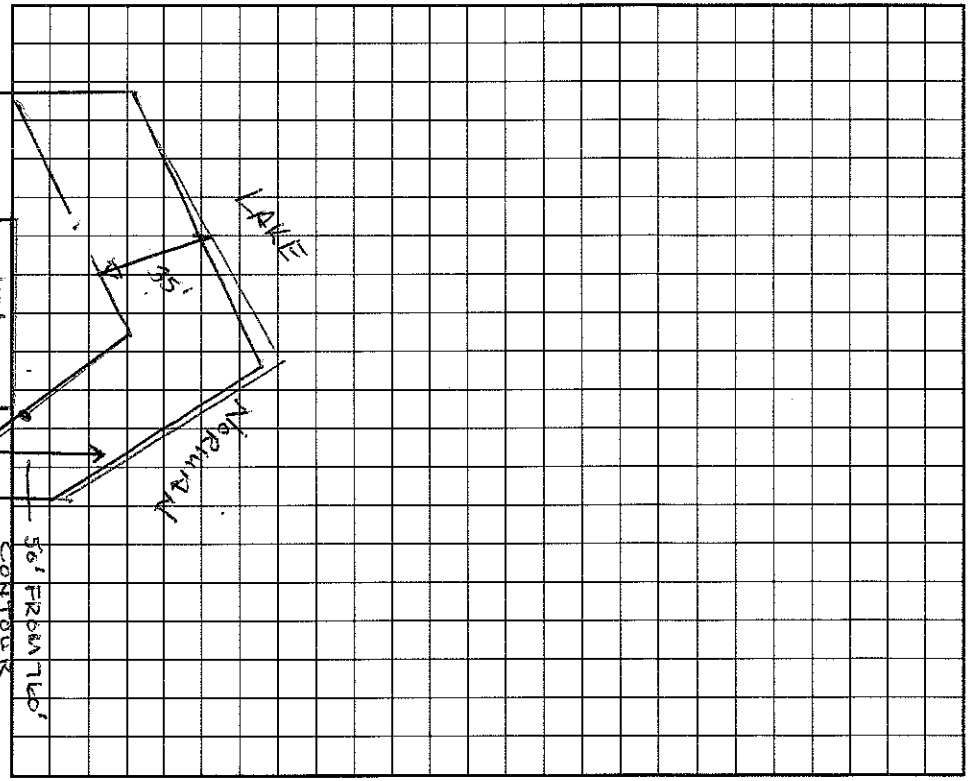

I understand that this permit can be suspended or revoked if any false information is supplied toward securing the permit/any unauthorized changes are made to the site/any unauthorized changes are made in the installation of the system. Improvement Permit is valid for 60 months from date of issuance.

Signed: Earl Ray Hiatt

Improvement Permit by: Wesley Sparks R.S. date 5/19/95

Existing System Inspection by: _____ date _____

Installed by: Tim Simmons

Certificate of Completion by: Wesley Sparks R.S. date 4/25/96

Operation Permit by: Wesley Sparks R.S. date 4/25/96

HEALTH DEPT. COPY: WHITE INSPECTION COPY (FINAL): GREEN OWNER COPY (FINAL): YELLOW INSPECTION COPY (INITIAL): PINK OWNER COPY (INITIAL): GOLD