IREDELL COUNTY HEALTH DEPARTMENT

STATESVILLE 704-878-5305 MOORESVILLE 704-664-5281

IMPROVEMENT PERMIT / CERTIFICATE OF COMPLETION / OPERATION PERMIT / EXISTING SYSTEM INSPECTION

PROPERTY DESCRIPTION NO. 15801 DATE Sept 28, '93 4644-37-7592 TAX MAP NO. 2A97A7

OWNER OR CONTRACTOR Linda F. Holthouser PHONE: Business 892-0263 Home

ADDRESS Rt 11, Box 1380, Mooresville

LOCATION 115 S. to 1102 T-L Mecklynes Rd. Bear Rt at end

SUBDIVISION West Lakes BLOCK / SECTION LOT 7 LOT AREA 20,000ft² SITE CLASS. 5 Spec 1956 L.T.A.R. .25 gal/ft²/day

Water Supply: ☑ Individual ☐ Community ☐ Public

Septic Tank: 1000 Gallons; STB 744 Dellinger Date Aug 9, '93

Pump Tank: 1000 Gallons; PT 27 Dellinger Date July 11, '93

Nitrification Field: No Fields 1 Square Feet Linear Feet 160

No Lines 3 Trench Width 24" Trench Depth 28-36" Gravel Depth NA

☑ New System ☐ Repair System Type: I, II, III, (IV) V, VI

System Description: LP PPBPS

Repair System Description: Same

Maintenance Agreement Required: ☑ Yes ☐ No

☑ House/Mod. Home No. Bedrooms 2

☐ Mobile Home No. Bathrooms 2F, 2(½)

☐ Business No. Employees

☐ Other

☐ Slab ☑ Crawl Space ☐ Basement w/plumbing ☐ Basement wo/plumbing

Garbage Disposal: ☑ Yes ☐ No

Auto. Dishwasher: ☑ Yes ☐ No


Auto. Washing Machine: ☑ Yes ☐ No

Other

Comments

INITIAL SITE SKETCH

AS BUILT SKETCH

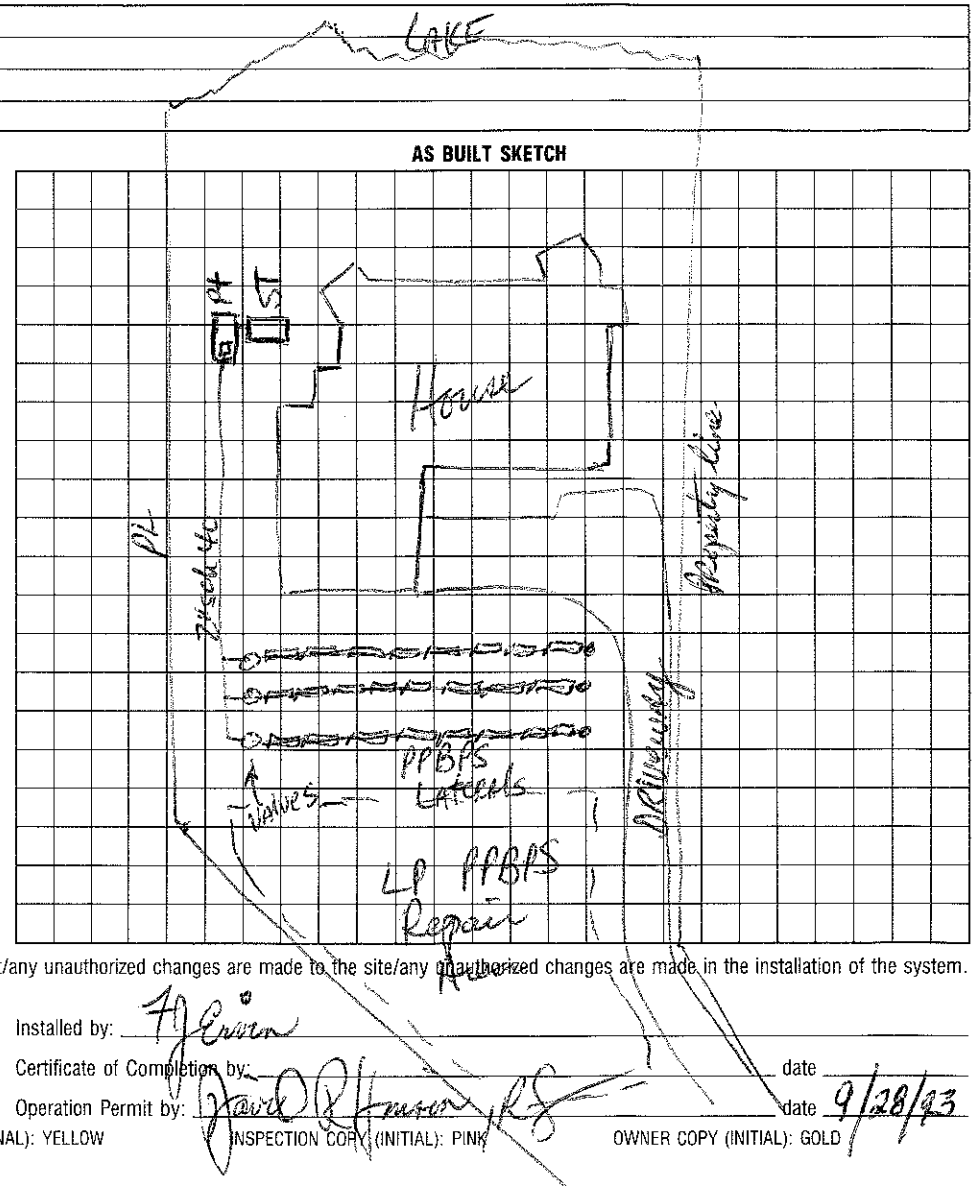

I understand that this permit can be suspended or revoked if any false information is supplied toward securing the permit/any unauthorized changes are made to the site/any unauthorized changes are made in the installation of the system. Improvement Permit is valid for 60 months from date of issuance.

Signed:

Improvement Permit by: date

Existing System Inspection by: date

Installed by: T. Erwin

Certificate of Completion by: date

Operation Permit by: David R. Hanson, RS date 9/28/93

HEALTH DEPT. COPY: WHITE INSPECTION COPY (FINAL): GREEN OWNER COPY (FINAL): YELLOW INSPECTION COPY (INITIAL): PINK OWNER COPY (INITIAL): GOLD