(112511)

IREDELL COUNTY HEALTH DEPARTMENT

STATESVILLE 704-878-5305 50.00 Paid MOORESVILLE 704-664-5281

IMPROVEMENT PERMIT / AUTHORIZATION TO CONSTRUCT / OPERATION PERMIT / EXISTING SYSTEM INSPECTION

PERMIT# 066505 PIN# 4644481479 4644-38-8144 DATE 8-29-2002

OWNER OR CONTRACTOR J. Scott Keadle PHONE: Business (704) 633-7060 Home (704) 650-0249

ADDRESS 480 Jake Alexander Blvd. W. Salisbury, NC 28147 (1135 Sea Hide Ct.)

LOCATION Hwy 115 S to Langtree TL (South) on Mocklynn Rd TR Sea Hide Ct

SUBDIVISION Westview BLOCK / SECTION . LOT 18 LOT AREA .73 Acre SITE CLASS. PS DESIGN FLOW 480 gpd L.T.A.R. .3

Septic Tank: 1000 Gallons; STB 925 Date 5-4-03
Pump Tank: 1000 Gallons; PT 302 Date 4-9-03
Pump Make: ZOELLER Model N137 Serial No.
Nitrification Field: No Fields 1 Square Feet 600' Linear Feet 300'
No Lines 5@60' Trench Width 24"-36" Max Trench Bottom Depth 30"

[X] New System [ ] Repair System Type: I, II, III, (IV), V
System Description: Pump-LP Panel Block
Repair System Description: Same
Maintenance Agreement Required: [X] Yes [ ] No


[X] House/Mod. Home No. Bedrooms 4
[ ] Mobile Home No. Bathrooms 3.5
[ ] Business No. Employees
[ ] Other
Gravel Depth N/A [ ] Slab [X] Crawl Space [ ] Basement w/plumbing [ ] Basement wo/plumbing

Water Supply: [X] Individual [ ] Public [ ] Community


Comments/Conditions: Keep Septic System at least 10' to PL, 50' from Jake and at least 50' from any well.

Comments/Conditions:

INITIAL SITE SKETCH Scale 1:50

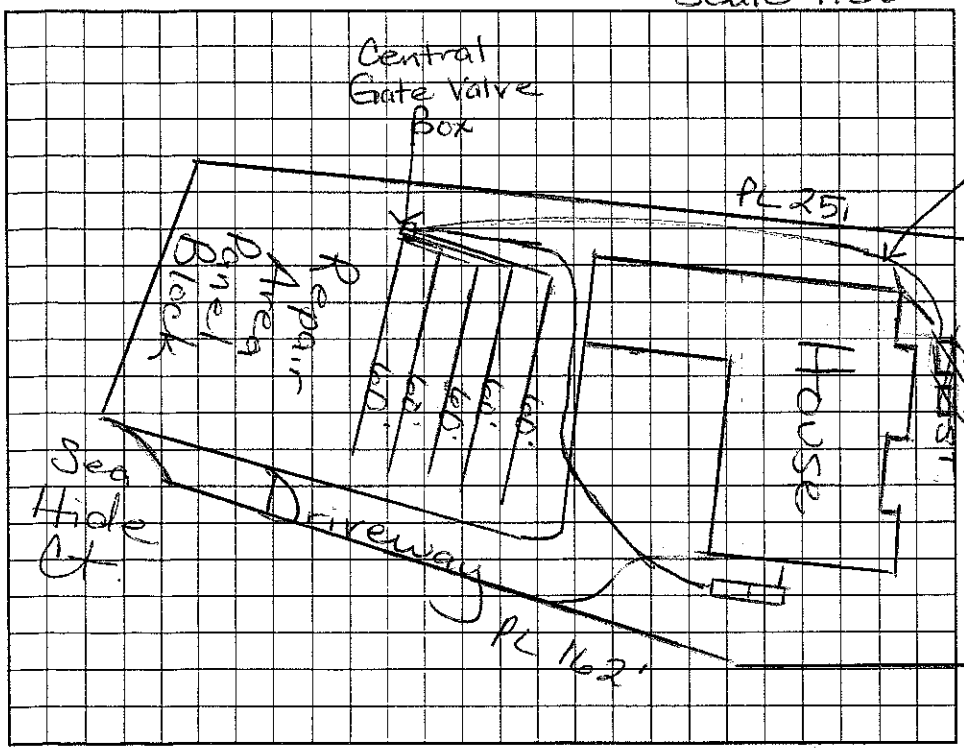

AS BUILT SKETCH

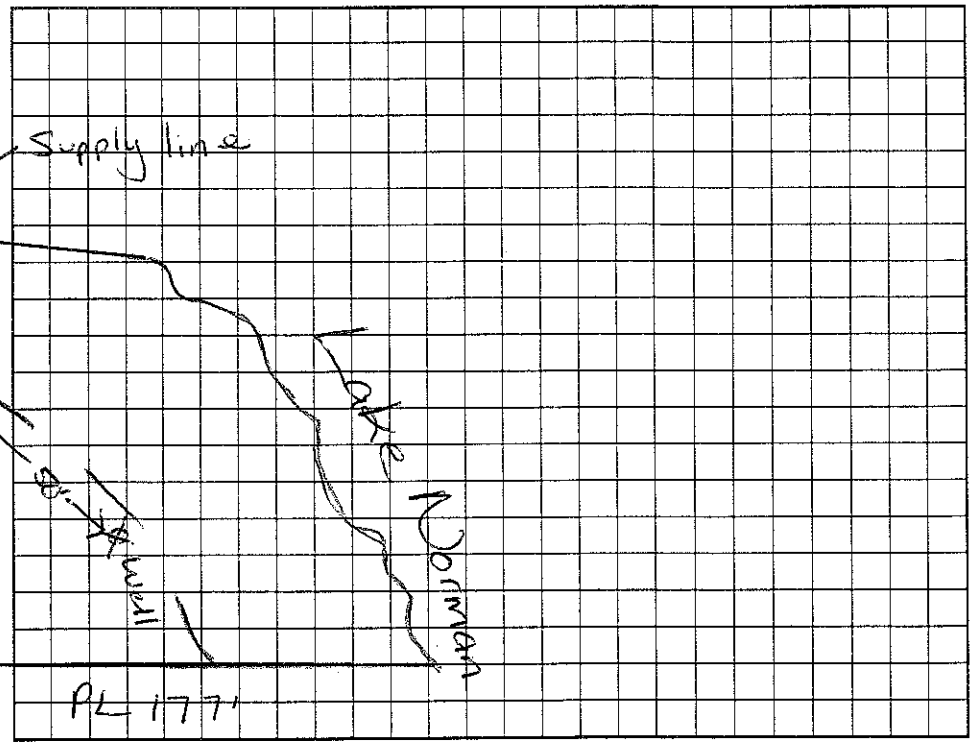

Permit can be suspended or revoked if any false information is supplied toward securing the permit/any unauthorized changes are made to the site/any unauthorized changes are made in the installation of the system. Improvement Permit with plat valid without expiration. Improvement Permit with site plan valid for sixty months. Authorization to Construct is valid for a period equal to that of Improvement Permit – not to exceed sixty months.

Signed: Richard M Harvey date 8/30/02 Installed by: Rowan Septic

Improvement Permit by: Maria H Dotson RS date 8/29/2002 Operation Permit by: Wesley Sparks R.S. date 8/14/03

Authorization to Construct by: Maria H Dotson RS date 8/29/2002 Existing System Inspection by: date

HEALTH DEPT. COPY: WHITE OWNER COPY (FINAL): YELLOW OWNER COPY (INITIAL): PINK