IREDELL COUNTY HEALTH DEPARTMENT

STATESVILLE 704-878-5305 MOORESVILLE 704-664-5281

Const. Add'l

IMPROVEMENT PERMIT / CERTIFICATE OF COMPLETION / OPERATION PERMIT / EXISTING SYSTEM INSPECTION

PROPERTY DESCRIPTION NO. 066501 DATE 7/8/97 TAX MAP NO. 4644481479 4644388484 Watershed: X Yes ☐ No

OWNER OR CONTRACTOR Crescent Resources / Thomas Long PHONE: Business 6063-6905 Home

ADDRESS P.O. Box 1003 Charlotte NC 28201

LOCATION Langtree Tr Mecklynn Tr West Paces Tr ~~High Sail Ct.~~ SAIL HIGH CT.

SUBDIVISION Westview BLOCK / SECTION LOT 13 LOT AREA 0.96 ac SITE CLASS PS DESIGN FLOW 480 gpd L.T.A.R. .3

Septic Tank: 1000 Gallons; STB 249 Date 2/3/99

Pump Tank: 1000 Gallons; PT 27 Date 11/21/98

Pump Make: Hydromatic Model SK5CAI Serial No. 11/98

Nitrification Field: No Fields 1 Square Feet 1200 Linear Feet 400

No Lines ~~End 80'~~ Trench Width 36" Max Trench Bottom Depth 36" Gravel Depth N/A

X New System ☐ Repair System Type: I, II, (III), IV, V, VI

System Description: Pump - Plastic Chamber Conventional

Repair System Description: Same

Maintenance Agreement Required: ☐ Yes X No

X House/Mod. Home ☐ Mobile Home ☐ Business ☐ Other

No. Bedrooms 3 No. Bathrooms 3 No. Employees


☐ Slab ☐ Crawl Space ☐ Basement w/plumbing ☐ Basement wo/plumbing

Water Supply: X Individual ☐ Community ☐ Public


Comments: * Install inspection ports near end of each lateral.
* 3 Bedroom = 400' Conventional - mp

Comments: NEED FLOAT TREE IN PUMP TANK
GATE VALVE IN PUMP TANK

INITIAL SITE SKETCH Scale 1:50

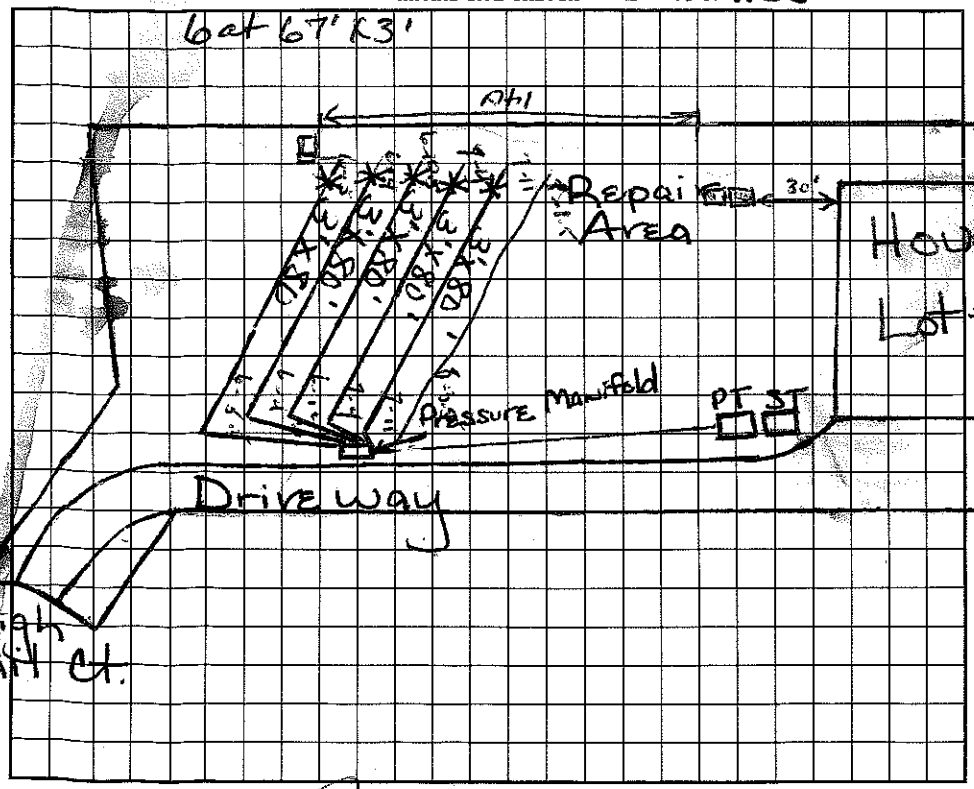

AS BUILT SKETCH

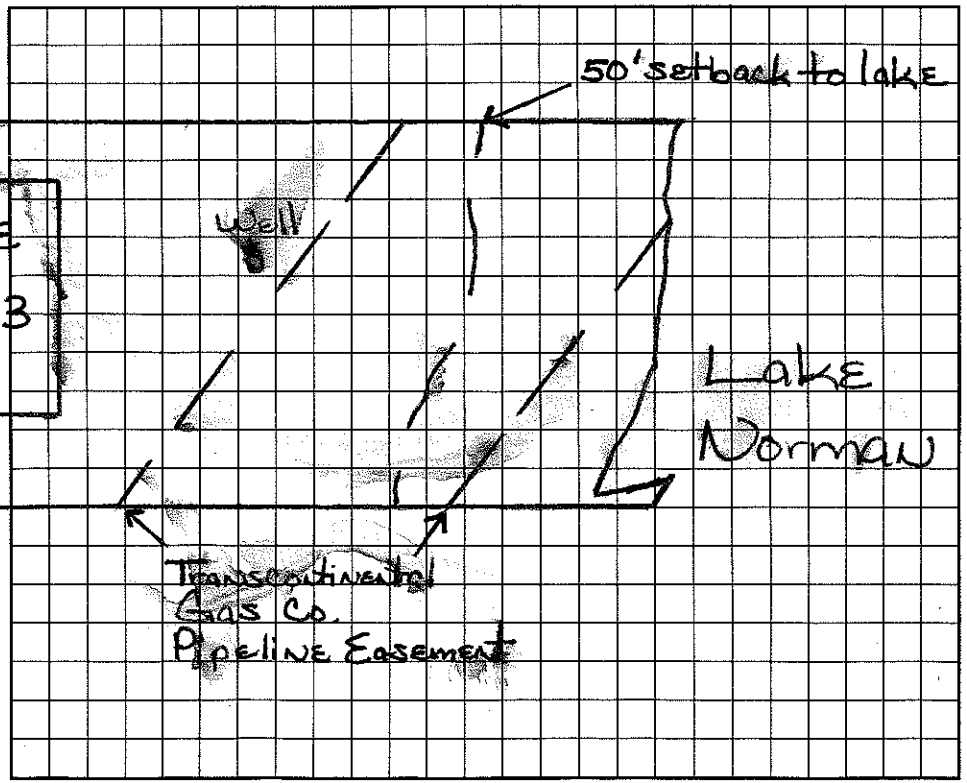

I understand that this permit can be suspended or revoked if any false information is supplied toward securing the permit/any unauthorized changes are made to the site/any unauthorized changes are made in the installation of the system. Improvement Permit is valid for 60 months from date of issuance.

Signed: Agent 8/5/97

Improvement Permit by: Maria H. Dotson date 7/8/97

System Inspection by: Maria H. Dotson date 8/4/98

Installed by: Claudius Morrison

Certificate of Completion by: date

Operation Permit by: date 5/6/99

DEPT. COPY: WHITE INSPECTION COPY (FINAL): GREEN OWNER COPY (FINAL): YELLOW INSPECTION COPY (INITIAL): PINK OWNER COPY (INITIAL): GOLD