IREDELL COUNTY HEALTH DEPARTMENT

STATESVILLE 704-878-5305 MOORESVILLE 704-664-5281

IMPROVEMENT PERMIT / CERTIFICATE OF COMPLETION / OPERATION PERMIT / EXISTING SYSTEM INSPECTION

PROPERTY DESCRIPTION NO. 06652 DATE 3/8/97 TAX MAP NO. 4679 Watershed: ☒ Yes ☐ No

OWNER OR CONTRACTOR [illegible] PHONE: Business 664-6605 Home

ADDRESS PO Box 1005 [illegible]

LOCATION [illegible] SAIL HIGH CT.

SUBDIVISION [illegible] BLOCK / SECTION ____ LOT 13 LOT AREA .96 Acres SITE CLASS. ES DESIGN FLOW 480 gpd L.T.A.R. .3

Septic Tank: 1000 Gallons; STB 219 Date 2/2/98

Pump Tank: 1000 Gallons; PT 29 Date 11/21/98

Pump Make: Hydromatic Model SK50A1 Serial No. 11198

Nitrification Field: No Fields ____ Square Feet 1200 Linear Feet 400

No Lines [illegible] Trench Width 36" Max Trench Bottom Depth 26" Gravel Depth N/A

☒ New System ☐ Repair System Type: I, II, III, IV, V, VI

System Description: Pump - Pressure Distribution

Repair System Description: [illegible]

Maintenance Agreement Required: ☐ Yes ☒ No

☒ House/Mod. Home No. Bedrooms 3

☐ Mobile Home No. Bathrooms 3

☐ Business No. Employees ____

☐ Other ____

☐ Slab ☐ Crawl Space ☐ Basement w/plumbing ☐ Basement wo/plumbing

Water Supply: ☒ Individual ☐ Community ☐ Public

Comments: * Initial location point near end of [illegible]


* 2 Proposed = 4/0" Conventional Dist

Comments:


NEED FLOAT TREE IN PUMP TANK

GATE VALVE IN PUMP TANK

INITIAL SITE SKETCH Scale 1:50

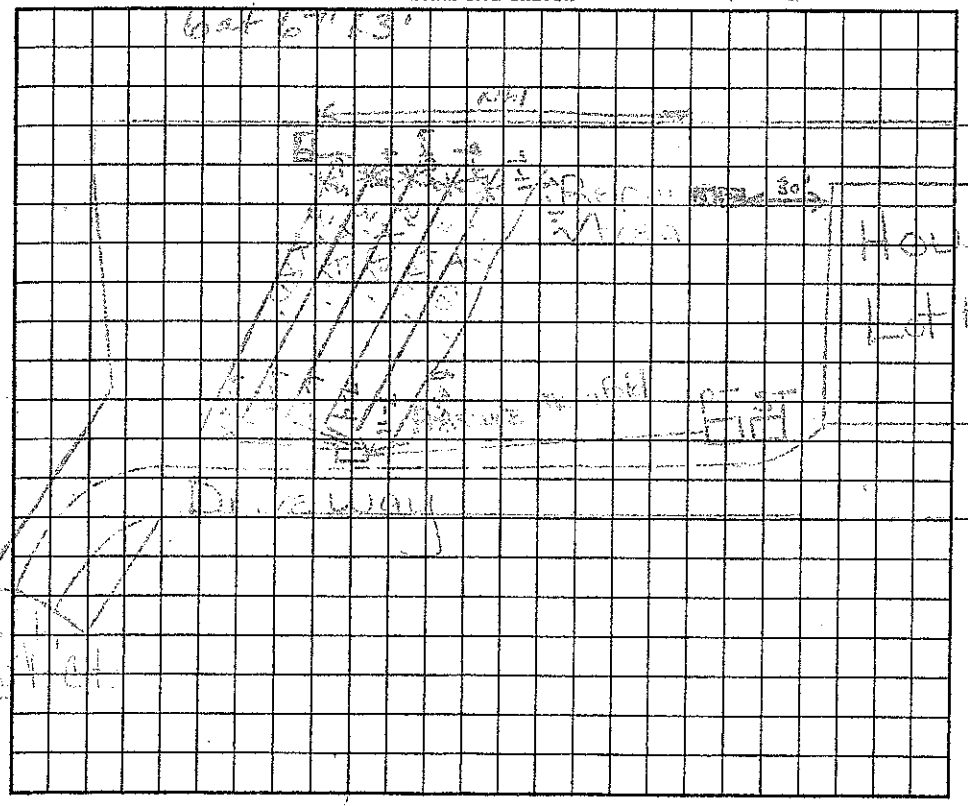

AS BUILT SKETCH

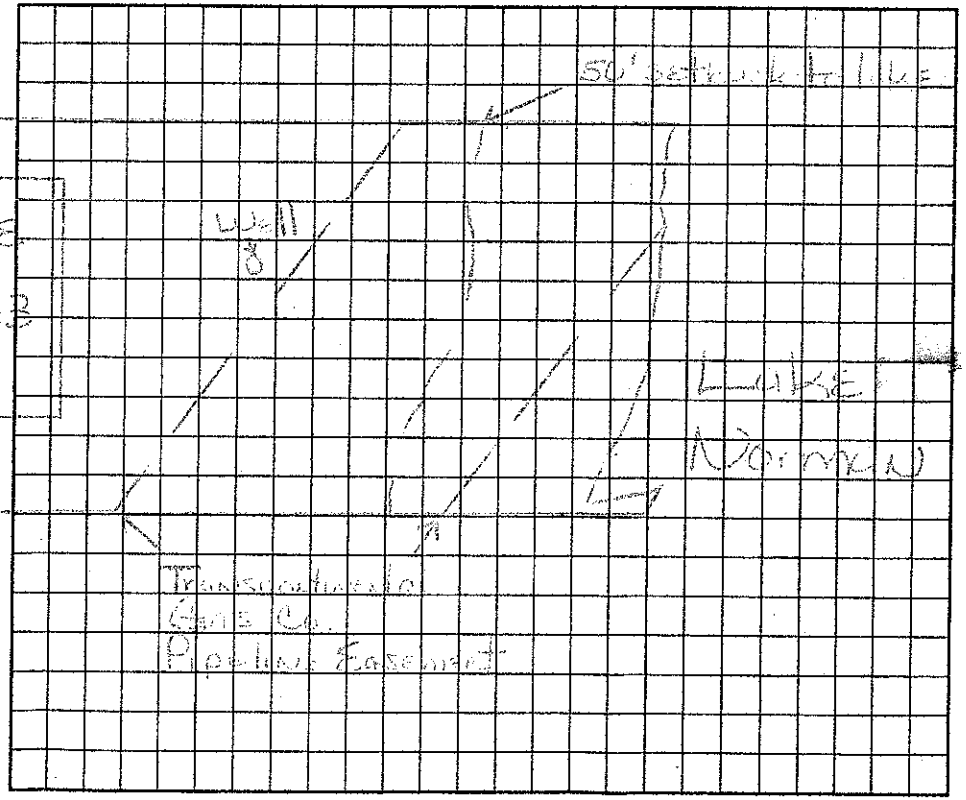

I understand that this permit can be suspended or revoked if any false information is supplied toward securing the permit/any unauthorized changes are made to the site/any unauthorized changes are made in the installation of the system. Improvement Permit is valid for 60 months from date of issuance.

Signed: [illegible] 3/8/97 Final 6/99

Improvement Permit by: [illegible] date 7/5/97

Existing System Inspection by: [illegible] date 7/4/98

Installed by: Claudius Morrison

Certificate of Completion by: ____ date ____

Operation Permit by: ____ date ____

HEALTH DEPT. COPY: WHITE INSPECTION COPY (FINAL): GREEN OWNER COPY (FINAL): YELLOW INSPECTION COPY (INITIAL): PINK OWNER COPY (INITIAL): GOLD