IREDELL COUNTY HEALTH DEPARTMENT

STATESVILLE 704-878-5305 MOORESVILLE 704-664-5281

IMPROVEMENT PERMIT / AUTHORIZATION TO CONSTRUCT / OPERATION PERMIT / EXISTING SYSTEM INSPECTION

PERMIT# 150501 PIN# 4644388484 DATE 6-2-08

OWNER OR APPLICANT White House Builders (Thomas Loop) PHONE: Business 799-9500 Home Dave 309-4301

ADDRESS P.O Box 4301 Mooresville NC 28117 - 111 SAILHIGHCT

LOCATION Langtree Rd TL Mecklyn Rd TR West Paces TL High Sail Ct

SUBDIVISION Westview BLOCK / SECTION ____ LOT 113 LOT AREA .96 Acre SITE CLASS. PS DESIGN FLOW 450gpd L.T.A.R. .3

Existing / Add

Septic Tank: 1000 / 1000 Gallons: STB ____ Date ____

Pump Tank: 1000 Gallons: PT ____ Date ____

Pump Make: ____ Model ____ Serial No. ____

Nitrification Field: No Fields 1 Square Feet 402 Linear Feet 134

No Lines 2 Trench Width 36" Max Trench Bottom Depth 36 Gravel Depth N/A ☐ Gravity ☒ Pressure

☐ New System ☐ Repair ☒ Expansion System Type: I II III IV V VI

System Description: Gravity-Conventional Accepted

Repair System Description: Loop 25%-50% Reduction

Maintenance Agreement Required: ☐ Yes ☒ No

☒ House/Mod. Home ☐ Mobile Home ☐ Business ☐ Other

No. Bedrooms 4 No. Persons ____ No. Employees ____

Water Supply: ☒ Individual ☐ Public ☐ Community

☐ Slab ☒ Crawl Space ☐ Basement w/plumbing ☐ Basement wo/plumbing

Comments/Conditions: Install 2-extra lines below existing Drainfield or okay to install above Drainfield however Pressure Manifold (PM) will have to be re

Comments/Conditions: Note; IF existing taps are 1½" sch 40 then use ½" sch 80 for 50ft lines @ 100ft - 25% Reduction Drainfield

UPGRADE Septic System From 3 Bedroom to 4 Bedrm.

INITIAL SI

The proposed / existing Bonus Room addition does not appear to impact the existing septic system.

**NOTE: Room CANNOT BE BEDROOM


R.S.

Date: 1/31/13

ICHD-Environmental Health Division

#201258

AS BUILT SKETCH

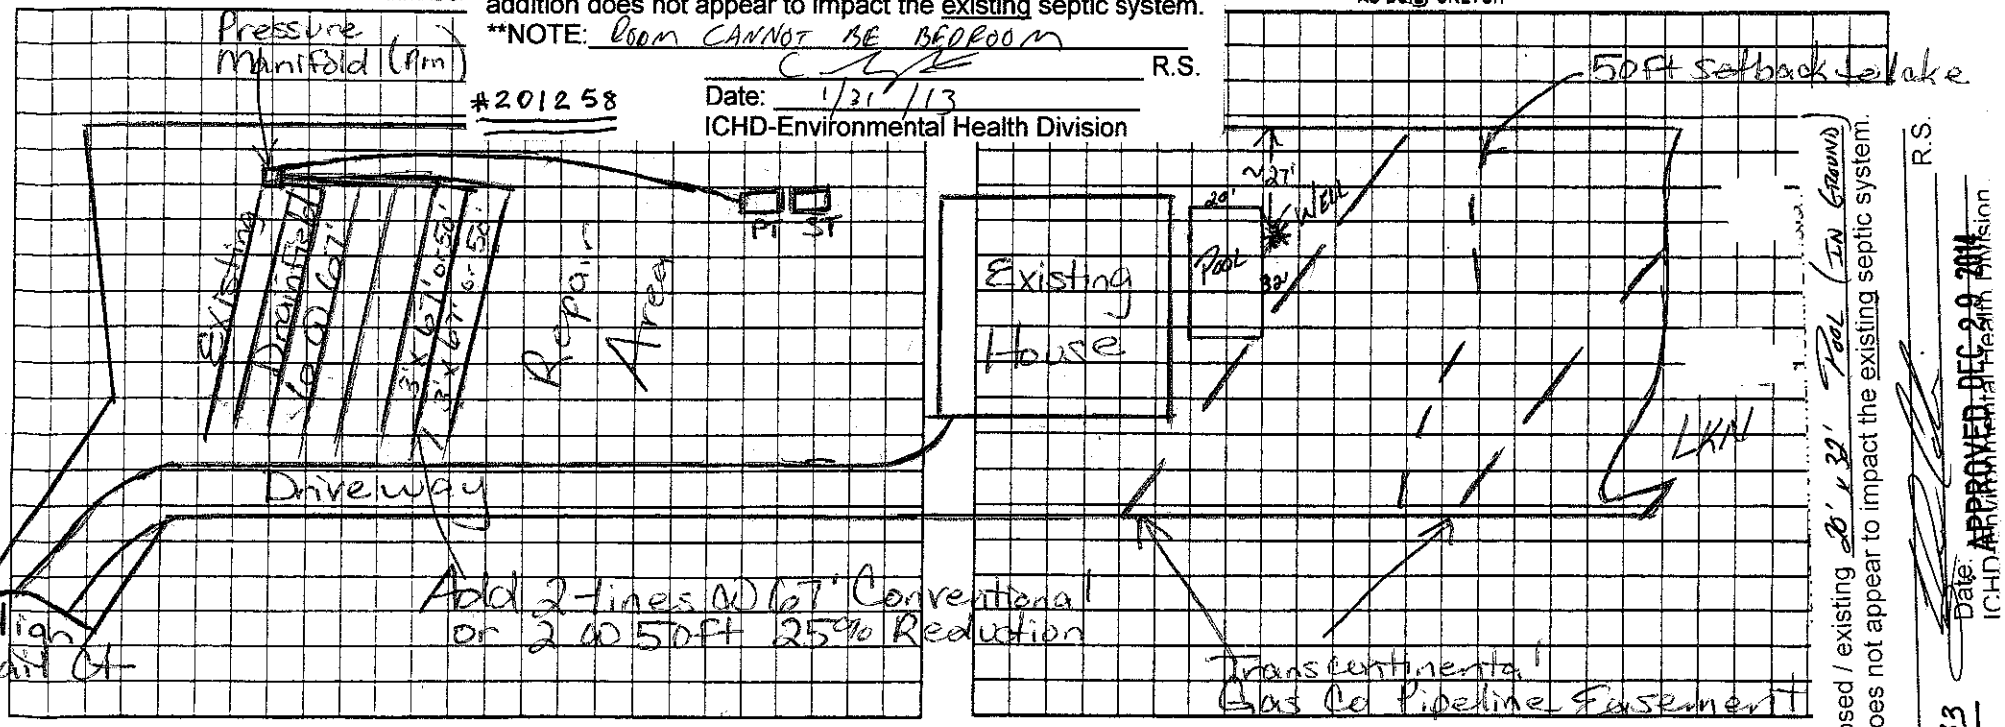

Permit can be suspended or revoked if any false information is supplied toward securing the permit/any unauthorized changes are made to the site/any unauthorized changes are made in the installation of the system. Impro

Permit with plat valid without expiration ☐ Improvement Permit with site plan valid for sixty months ☐ Authorization to Construct is valid for a period equal to that of Improvement Permit – not to exceed sixty

Signed: ____ date 6/3/08 Installed by: ____

Improvement Permit by: ____ RS date 6/2/08 Operation Permit by: Wesley Sparks R.S. date 6/20/08

Authorization to Construct by: ____ RS date 6/2/08 Existing System Inspection by: ____ date ____

HEALTH DEPT. COPY: WHITE OWNER COPY (FINAL): YELLOW OWNER COPY (INITIAL): PINK

The proposed / existing 20' x 32' Pool (IN GROUND) addition does not appear to impact the existing septic system.

**NOTE: ____

R.S.

Date: APPROVED DEC 2 9 2014

ICHD-Environmental Division

#207433