IREDELL COUNTY HEALTH DEPARTMENT - *ENVIRONMENTAL HEALTH* ☐ STATESVILLE OFFICE 704-878-5305 ☒ MOORESVILLE OFFICE 704-664-5281

IMPROVEMENT PERMIT / AUTHORIZATION TO CONSTRUCT / OPERATION PERMIT / EXISTING SYSTEM INSPECTION

PERMIT # 1683CH PIN # 4644-38-9692 DATE 8-31-11

OWNER Tim Rein / Charlotte APPLICANT: CH. Pools & Spas PHONE: Home/Cell # 704-799-7575 Business #

SITE ADDRESS 112 Sail High Ct OWNER / APPLICANT ADDRESS SAME

SITE DIRECTIONS Alcove, West Paces, Sail High

SUBDIVISION Westview BLOCK / SECTION LOT # 11 LOT AREA 1.13 AC DESIGN FLOW 480 L.T.A.R. .3

Septic Tank Ex 1000 Gallons: STB Date

Pump Tank Ex. 1000 Gallons: PT Date

Pump Make Model Serial #

No. Nitrification Fields: No. Lines EXISTING Linear Feet

Trench Width Max. Trench Bottom Depth Gravel Depth

☐ New System ☐ Repair ☐ Expansion System Type I II (III) IV V VI

System Description: PM - 25% (CHAMBERS)

Repair System Description: LP - PANEL

Maintenance Agreement Required ☐ YES ☒ NO INITIALLY

☐ GRAVITY ☒ PRESSURE

☒ Residence No. Bedrooms 4

☐ Business No. Persons

☒ Other No. Employees

☐ Slab ☒ Crawl Space

☐ Basement w/plumbing ☐ Basement w/o plumbing


Water Supply: ☒ Private ☐ Public ☐ Community

Comments / Conditions


SPA

SAIL HIGH CT

INITIAL SITE SKETCH

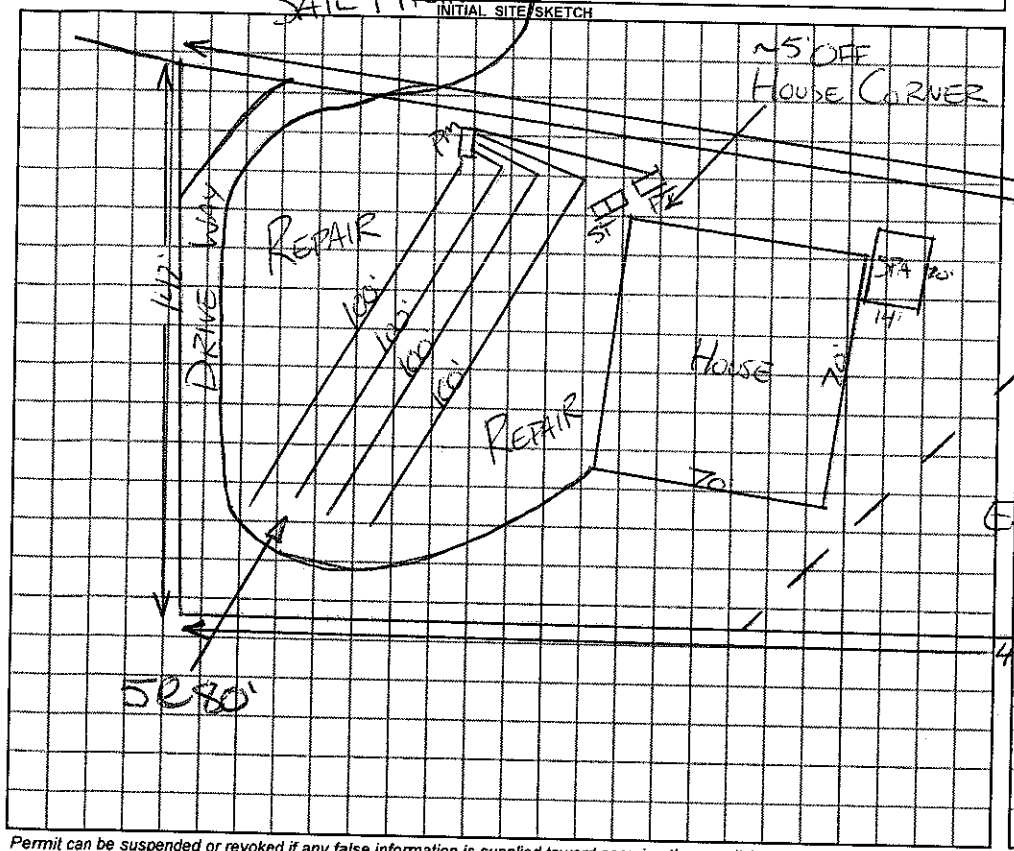

AS BUILT SKETCH

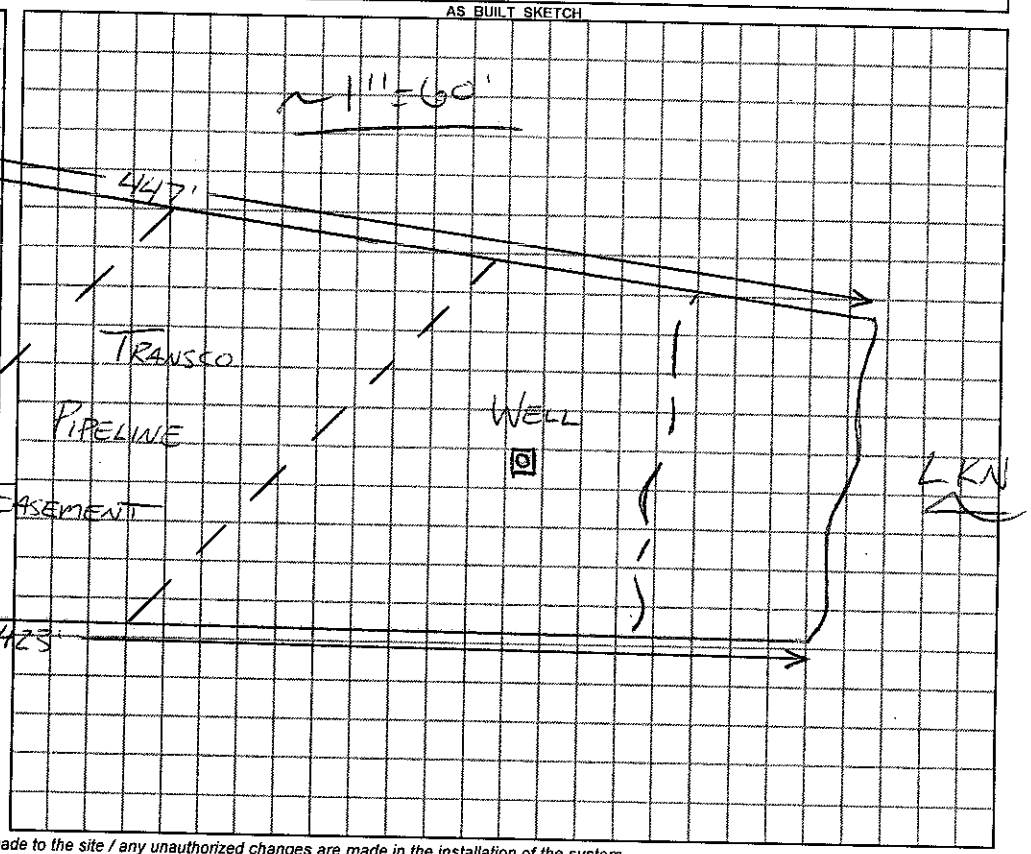

Permit can be suspended or revoked if any false information is supplied toward securing the permit / any unauthorized changes are made to the site / any unauthorized changes are made in the installation of the system.

☐ ***IMPROVEMENT PERMIT*** with plat valid without expiration. ☐ ***IMPROVEMENT PERMIT*** with plat valid without expiration. site plan valid 60 mo. ☐ ***AUTHORIZATION TO CONSTRUCT*** valid for period equal to IMPROVEMENT PERMIT--not to exceed 60 mo.

Owner / Applicant Signature: Colleen Rein Date 9-6-11 Installed by:

IMPROVEMENT PERMIT by: ***REHS*** Date OPERATION PERMIT by: ***REHS*** Date

AUTHORIZATION TO CONSTRUCT by: ***REHS*** Date Existing System Inspected by: ***REHS*** Date 8-31-11

YOU SHOULD CONTACT A LOCATOR SERVICE PRIOR TO ANY EXCAVATION

White Copy – Environmental Health YELLOW COPY (Final) Owner / Applicant PINK COPY (Initial) Owner / Applicant