IREDELL COUNTY HEALTH DEPARTMENT - *ENVIRONMENTAL HEALTH* ☐ STATESVILLE OFFICE 704-878-5305 ☒ MOORESVILLE OFFICE 704-664-5281

IMPROVEMENT PERMIT / AUTHORIZATION TO CONSTRUCT / OPERATION PERMIT / EXISTING SYSTEM INSPECTION

PERMIT # 168304 PIN # 4644-38-9692 DATE 8-31-11

OWNER Tim Bein / Charlotte Pools APPLICANT: CH. Pools & Spas PHONE: Home/Cell # 704-799-7575 Business #

SITE ADDRESS 112 Sail High Ct OWNER / APPLICANT ADDRESS SAME

SITE DIRECTIONS Alcove, West Paces, Sail High

SUBDIVISION Westview BLOCK / SECTION LOT # 11 LOT AREA 1.13 Ac DESIGN FLOW 480 L.T.A.R. .3

Septic Tank Ex 1000 Gallons: STB Date
Pump Tank Ex. 1000 Gallons: P T Date
Pump Make Model Serial #
No. Nitrification Fields: No. Lines EXISTING Linear Feet
Trench Width Max. Trench Bottom Depth Gravel Depth

☐ New System ☐ Repair ☐ Expansion System Type I II III IV V VI
System Description: PM - 25% (CHAMBERS)
Repair System Description: LP - PANEL
Maintenance Agreement Required ☐ YES ☒ NO INITIALLY
☐ GRAVITY ☒ PRESSURE


☒ Residence No. Bedrooms 4
☐ Business No. Persons
☒ Other No. Employees
☐ Slab ☒ Crawl Space
☐ Basement w/plumbing ☐ Basement w/o plumbing

Water Supply: ☒ Private ☐ Public ☐ Community


Comments / Conditions

SPA

INITIAL SITE SKETCH

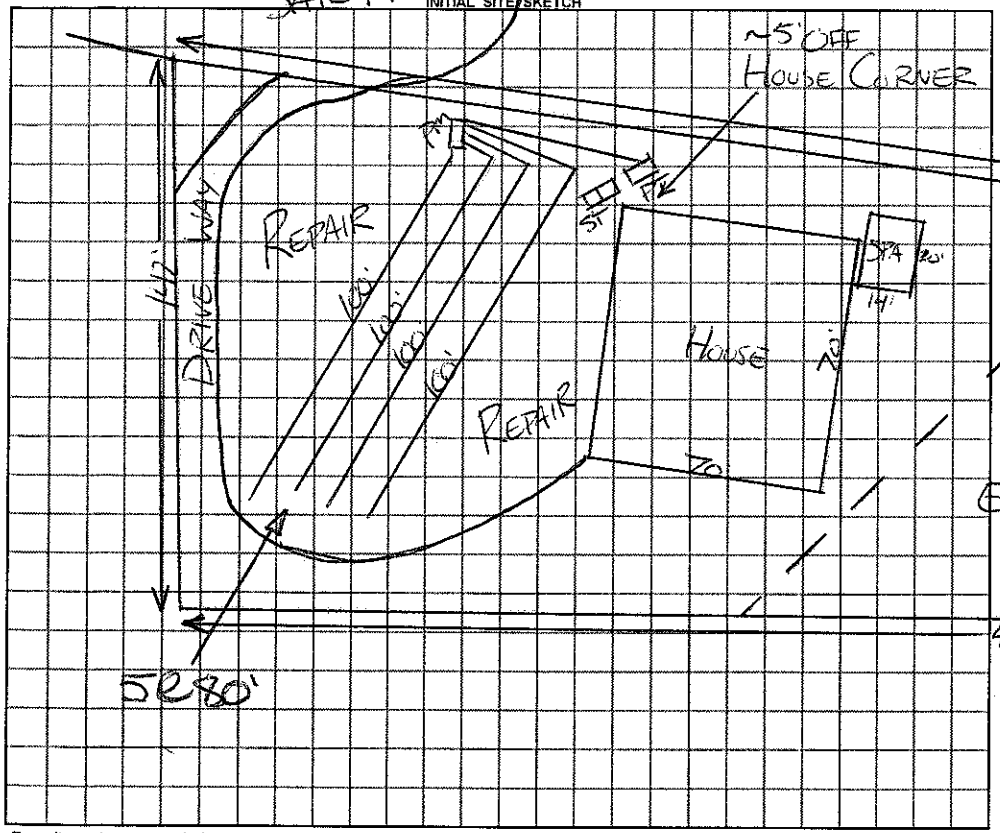

AS BUILT SKETCH

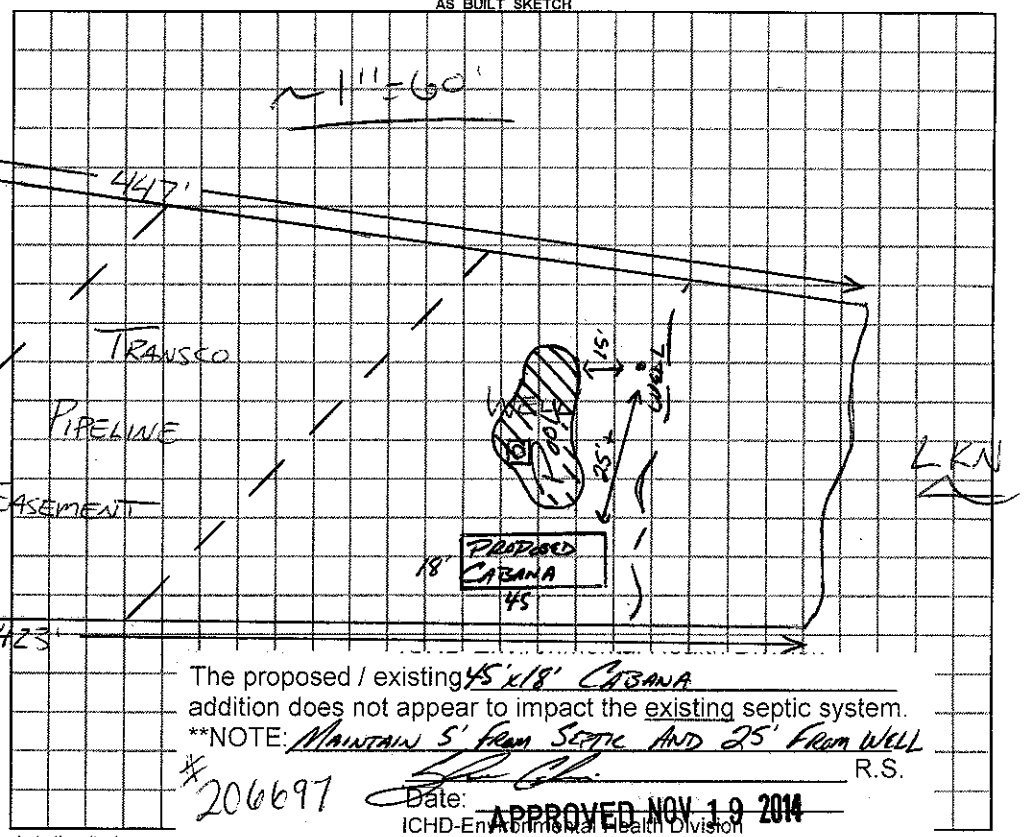

The proposed / existing 45'x18' CABANA addition does not appear to impact the existing septic system.
**NOTE: MAINTAIN 5' FROM SEPTIC AND 25' FROM WELL

R.S.

#206697 Date: APPROVED NOV 19 2014
ICHD-Environmental Health Division

Permit can be suspended or revoked if any false information is supplied toward securing the permit / any unauthorized changes are made to the site / any unauthorized changes are made in the installation of the system.

☐ ***IMPROVEMENT PERMIT*** with plat valid without expiration. ☐ ***IMPROVEMENT PERMIT*** with plat valid without expiration. site plan valid 60 mo. ☐ ***AUTHORIZATION TO CONSTRUCT*** valid for period equal to IMPROVEMENT PERMIT–not to exceed 60 mo.

Owner / Applicant Signature: Colleen Hyppa Date 9-6-11 Installed by:

IMPROVEMENT PERMIT by: REHS Date OPERATION PERMIT by: REHS Date

AUTHORIZATION TO CONSTRUCT by: REHS Date Existing System Inspected by: REHS Date 8-31-11

YOU SHOULD CONTACT A LOCATOR SERVICE PRIOR TO ANY EXCAVATION

White Copy – Environmental Health YELLOW COPY (Final) Owner / Applicant APPROVED NOV 19 2014 PINK COPY (Initial) Owner / Applicant