(10:30)

IREDELL COUNTY HEALTH DEPARTMENT

STATESVILLE 704-878-5305 MOORESVILLE 704-664-5281

IMPROVEMENT PERMIT / AUTHORIZATION TO CONSTRUCT / OPERATION PERMIT / EXISTING SYSTEM INSPECTION

PERMIT# 074287 PIN# 4644 47 2439 DATE 7/27/98

OWNER OR CONTRACTOR RAY SHORT PHONE: Business Home 664-6761

ADDRESS 40 STUTTS RD MOORESVILLE NC 28115

LOCATION LANETREE - TL MCLYNN - TR WESTPACES ON LT NEAR END

SUBDIVISION WESTPACES BLOCK / SECTION LOT 2 LOT AREA .56AC SITE CLASS. RS DESIGN FLOW ~~480~~ 360 L.T.A.R. .3

Septic Tank: 1000 Gallons; STB 794 Date 5/7/99

Pump Tank: 1000 Gallons; PT 27 Date 5/21/99

Pump Make: GOULDS Model WE0311M Serial No M9846420

Nitrification Field: No Fields 1 Square Feet 560 Linear Feet 250

No Lines 4@70' Trench Width 24" Max Trench Bottom Depth 28" Gravel Depth N/A

☑ New System ☐ Repair System Type: I, II, III, IV, V, VI

System Description: PUMP PANEL

Repair System Description: SAME

Maintenance Agreement Required: ☐ Yes ☑ No

☑ House/Mod. Home No. Bedrooms ~~3~~ 4

☐ Mobile Home No. Bathrooms 4

☐ Business No. Employees

☐ Other


☐ Slab ☑ Crawl Space ☐ Basement w/plumbing ☐ Basement wo/plumbing

Water Supply: ☑ Individual ☐ Public ☐ Community


Comments:/Conditions:

Comments:/Conditions:

INITIAL SITE SKETCH

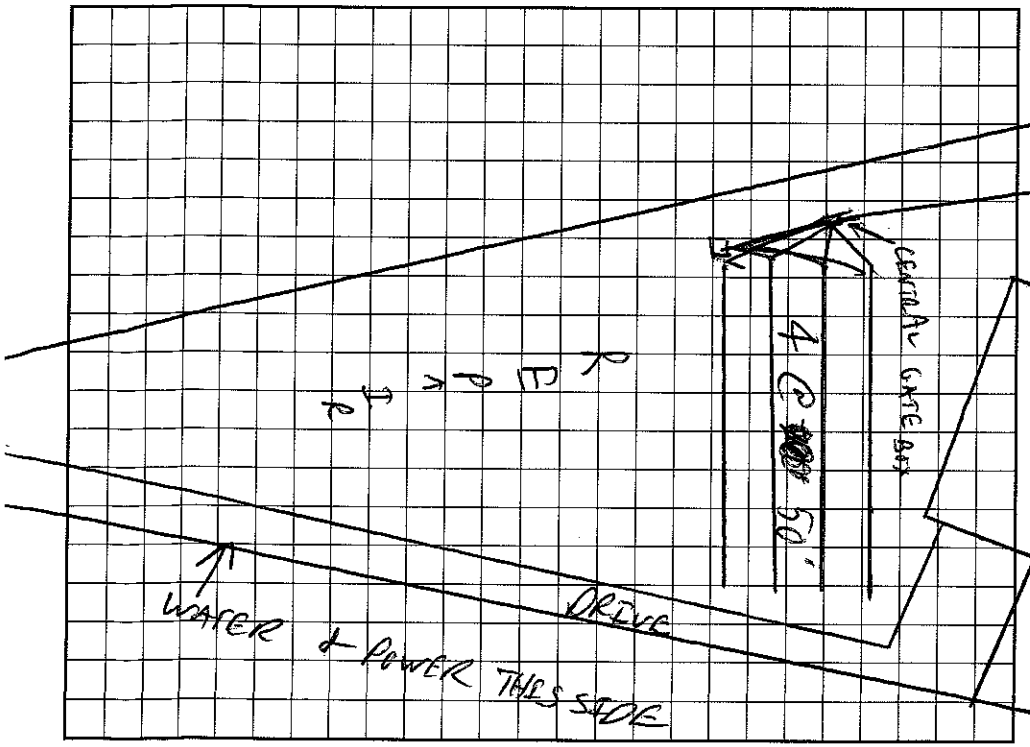

AS BUILT SKETCH

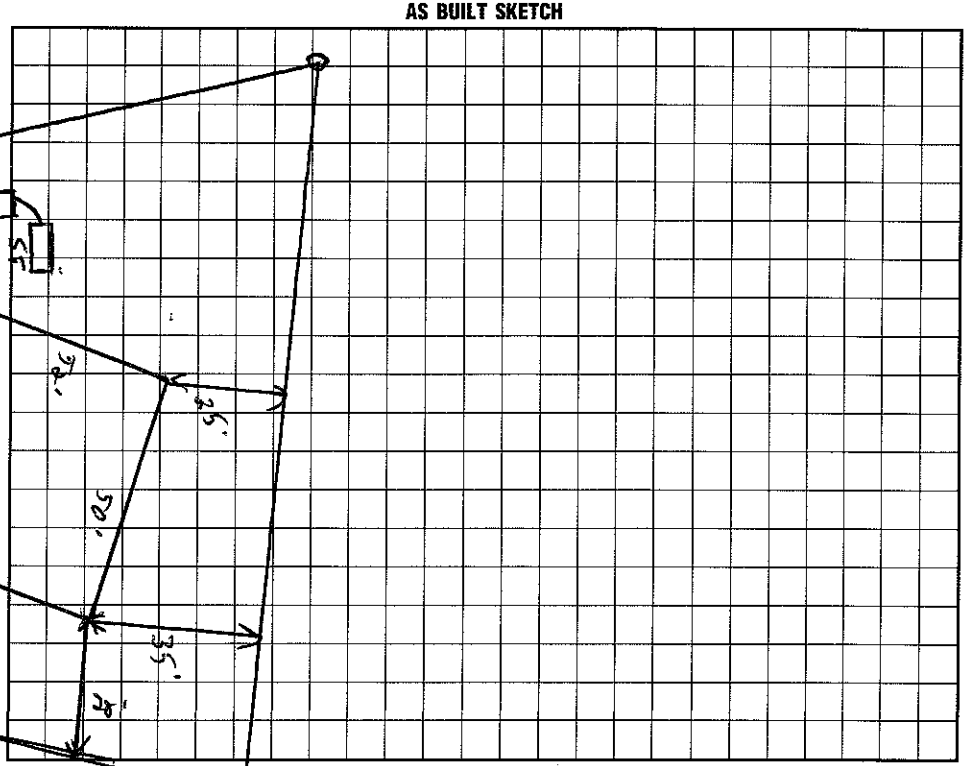

I understand that this permit can be suspended or revoked if any false information is supplied toward securing the permit/any unauthorized changes are made to the site/any unauthorized changes are made in the installation of the system. Improvement Permit with plat valid without expiration. Improvement Permit with site plan valid for sixty months. Authorization to Construct is valid for a period equal to that of Improvement Permit – not to exceed sixty months.

Signed: Ray Short date 8/10/98 Installed by: FJ ERVIN

Improvement Permit by: C. Ky Terrell RS date 7/27/98 Operation Permit by: C. Ky Terrell date 6/25/99

Authorization to Construct by: C. Ky Terrell RS date 7/27/98 Existing System Inspection by: date

HEALTH DEPT. COPY: WHITE INSPECTION COPY (FINAL): GREEN OWNER COPY (FINAL): YELLOW INSPECTION COPY (INITIAL): PINK OWNER COPY (INITIAL): GOLD