IREDELL COUNTY HEALTH DEPARTMENT

STATESVILLE 704-878-5305 MOORESVILLE 704-664-5281

IMPROVEMENT PERMIT / AUTHORIZATION TO CONSTRUCT / OPERATION PERMIT / EXISTING SYSTEM INSPECTION

PERMIT# 080463 PIN# 4644473506 DATE 4-12-99

OWNER OR CONTRACTOR Ray Short PHONE: Business Home 704-664-6761

ADDRESS 470 Stutts Rd., Mooresville NC 28115

LOCATION Alcove, to MECKLVN, TR West Paces, on LT

SUBDIVISION West Paces BLOCK / SECTION LOT 1 LOT AREA .57 SITE CLASS. PS DESIGN FLOW 360 L.T.A.R. .3

Septic Tank: 1000 Gallons; STB 312 Date 8-17-99

Pump Tank: 1000 Gallons; PT 27 Date 9-18-99

Pump Make: Goulds Model WE0311M Serial No. G9946239

Nitrification Field: No Fields 1 Square Feet 600 Linear Feet 200

No Lines 4@50' Trench Width 36" Max Trench Bottom Depth 36" Gravel Depth 12"

1/3 H.P.

☒ New System ☐ Repair System Type: I, II, (III) IV, V, VI

System Description: Pump/Pressure Manif/ Panel

Repair System Description: Same

Maintenance Agreement Required: ☐ Yes ☐ No

☒ House/Mod. Home No. Bedrooms 3

☐ Mobile Home No. Bathrooms 2

☐ Business No. Employees

☐ Other


☐ Slab ☐ Crawl Space ☐ Basement w/plumbing ☐ Basement wo/plumbing

Water Supply: ☐ Individual ☐ Public ☒ Community


Comments:/Conditions: Keep lines on Contour
Keep septic 10' off PL & 5' off House
Filter & riser installed.

Comments:/Conditions: Tanks & lines & pressure tested 10/22/99 MD

INITIAL SITE SKETCH

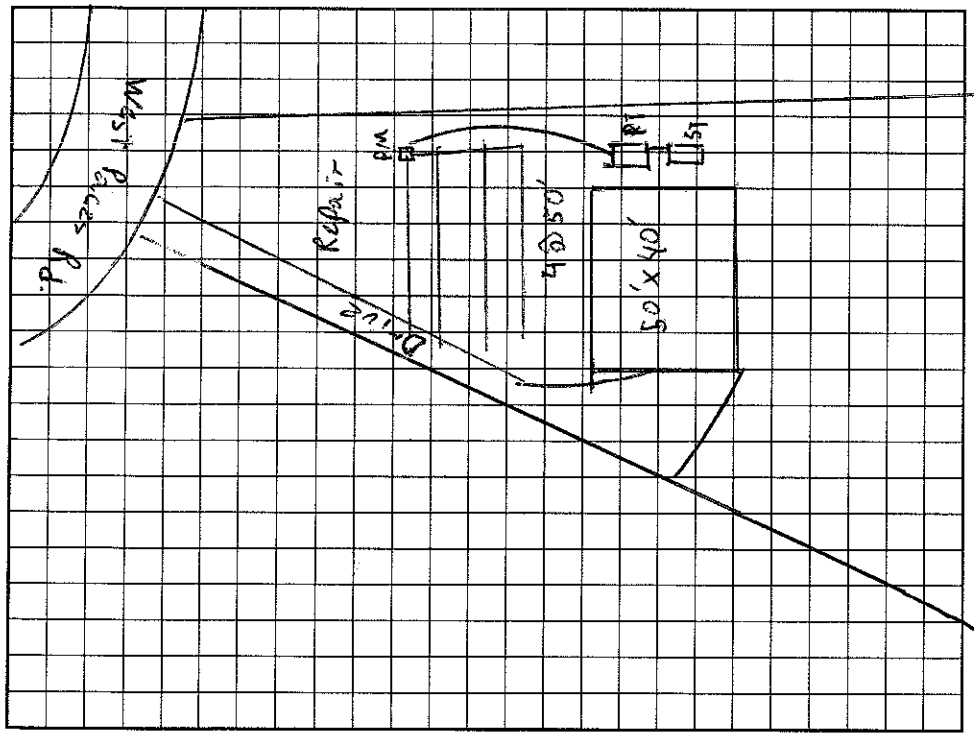

AS BUILT SKETCH

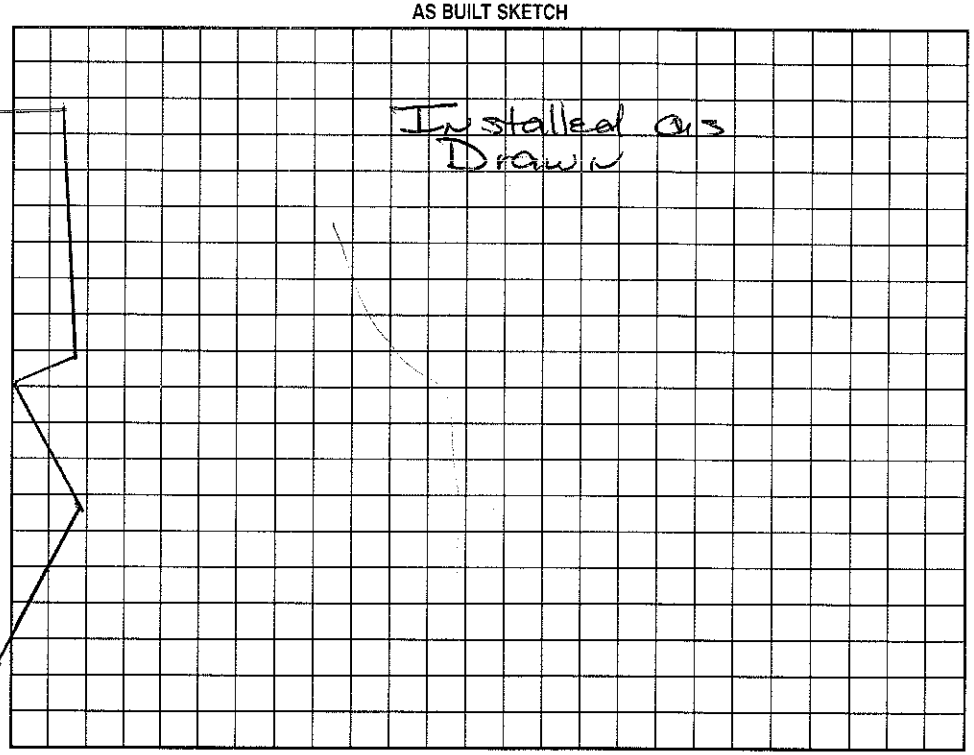

Permit can be suspended or revoked if any false information is supplied toward securing the permit/any unauthorized changes are made to the site/any unauthorized changes are made in the installation of the system. Improvement Permit with plat valid without expiration. Improvement Permit with site plan valid for sixty months. Authorization to Construct is valid for a period equal to that of Improvement Permit – not to exceed sixty months.

Signed: date

Improvement Permit by: Jeff Morgan date 4/15/99

Authorization to Construct by: Jeff Morgan date 4/15/99

Installed by: F. J. Ervin

Operation Permit by: Wastewater Specialists RS. date 11/22/99

Existing System Inspection by: date

HEALTH DEPT. COPY: WHITE OWNER COPY (FINAL): YELLOW OWNER COPY (INITIAL): PINK