4644-48-1036

IREDELL COUNTY HEALTH DEPARTMENT

STATESVILLE 704-878-5305 MOORESVILLE 704-664-5281

IMPROVEMENT PERMIT / CERTIFICATE OF COMPLETION / OPERATION PERMIT / EXISTING SYSTEM INSPECTION

PROPERTY DESCRIPTION NO. D67583 DATE 9/24/97 TAX MAP NO. 4644481479 Pt Watershed: ☒ Yes ☐ No

OWNER OR CONTRACTOR Crescent Resources PHONE: Business _____ Home _____

ADDRESS P.O Box 1003 Charlotte, NC 28201

LOCATION Langtree TL Mecklenn TR West Paces 1500Ft on Rt (corner of West Paces & Sea Hide Ct)

SUBDIVISION Westview BLOCK / SECTION J LOT 20 LOT AREA .54 SITE CLASS. PS DESIGN FLOW 480gpd L.T.A.R. .3

Septic Tank: 1000 Gallons; STB 794 Date 4/9/01

Pump Tank: 1000 Gallons; PT 283 Date 6/16/02

Pump Make: LittleGiant Model 9E14-CIA-AFG Serial No. _____

Nitrification Field: No Fields 1 Square Feet 560' Linear Feet 280'

No Lines 4 at 70' Trench Width 24" Max Trench Bottom Depth ~30" Gravel Depth N/A

☒ New System ☐ Repair System Type: I, II, III, ⓘ V, VI

System Description: Pump-Panel Blk

Repair System Description: Same

Maintenance Agreement Required: ☒ Yes ☐ No

☒ House/Mod. Home No. Bedrooms 4

☐ Mobile Home No. Bathrooms 4

☐ Business No. Employees _____

☐ Other _____


☐ Slab ☒ Crawl Space ☐ Basement w/plumbing ☐ Basement wo/plumbing

Water Supply: ☒ Individual ☐ Community ☐ Public

Comments: Well must be drilled well. 7/27/01 Reviewed plan - essentially complies with permit.

Comments:

INITIAL SITE SKETCH Scale 1:50

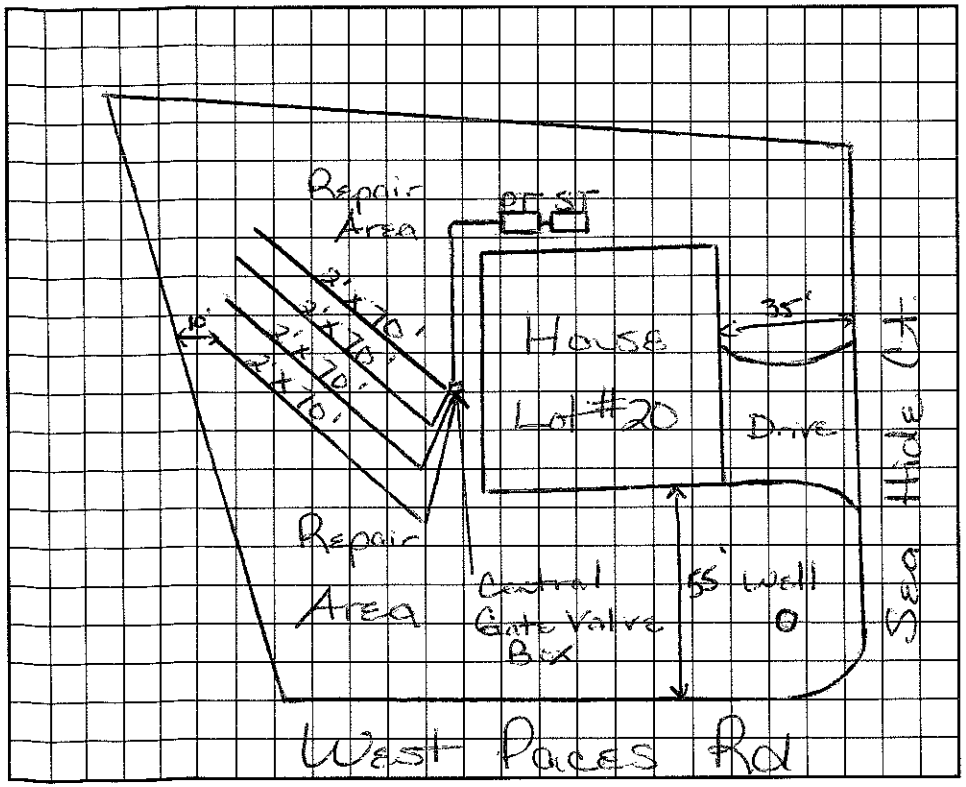

AS BUILT SKETCH

Installed As Drawn

I understand that this permit can be suspended or revoked if any false information is supplied toward securing the permit/any unauthorized changes are made to the site/any unauthorized changes are made in the installation of the system. Improvement Permit is valid for 60 months from date of issuance.

Signed: _____

Improvement Permit by: Mary H. Watson date 9/24/97

Existing System Inspection by: Wesley Sparks RS date 7/27/01

Installed by: Gerald Tucker

Certificate of Completion by: _____ RS date 10/24/02

Operation Permit by: _____ date _____

HEALTH DEPT. COPY: WHITE INSPECTION COPY (FINAL): GREEN OWNER COPY (FINAL): YELLOW INSPECTION COPY (INITIAL): PINK OWNER COPY (INITIAL): GOLD

ct. Auth