4644481275 3:30

IREDELL COUNTY HEALTH DEPARTMENT

STATESVILLE 704-878-5305 MOORESVILLE 704-664-5281

IMPROVEMENT PERMIT / CERTIFICATE OF COMPLETION / OPERATION PERMIT / EXISTING SYSTEM INSPECTION

PROPERTY DESCRIPTION NO. 067582 DATE 7/8/97 TAX MAP NO. 4644481479 PT Watershed: ☒ Yes ☐ No

OWNER OR CONTRACTOR Crescent Resources LP Allen PHONE: Business 663-6905 Home

ADDRESS P.O. Box 1003 Charlotte NC 28201

LOCATION Langtree Rd TL Mecklynn Rd TR West Paces TR Sea Hide Ct

SUBDIVISION Westview BLOCK / SECTION J LOT 15 LOT AREA 1.69 Ac SITE CLASS. PS DESIGN FLOW 480gpd L.T.A.R. .3

Septic Tank: 1000 Gallons; STB 1012 Date 7-17-01

Pump Tank: ____ Gallons; PT ____ Date ____

Pump Make: ____ Model ____ Serial No. ____

Nitrification Field: No Fields 1 Square Feet 1200 Linear Feet 400

No Lines 5 at 80' Trench Width 36" Max Trench Bottom Depth ≈36" Gravel Depth N/A

☒ New System ☐ Repair System Type: I, II, III, IV, V, VI

System Description: Gravity Plastic Cham

Repair System Description: Same

Maintenance Agreement Required: ☐ Yes ☐ No

☒ House/Mod. Home No. Bedrooms 4

☐ Mobile Home No. Bathrooms 2.5

☐ Business No. Employees ____

☐ Other ____


☐ Slab ☒ Crawl Space ☐ Basement w/plumbing ☐ Basement wo/plumbing

Water Supply: ☒ Individual ☐ Community ☐ Public


Comments: * Install inspection ports near end of laterals. Reviewed Building plans 5/7/2001 + seem in compliance with permit. MH

Comments: Installed "Drop Boxes" Didn't install inspection ports.

INITIAL SITE SKETCH Scale 1:50

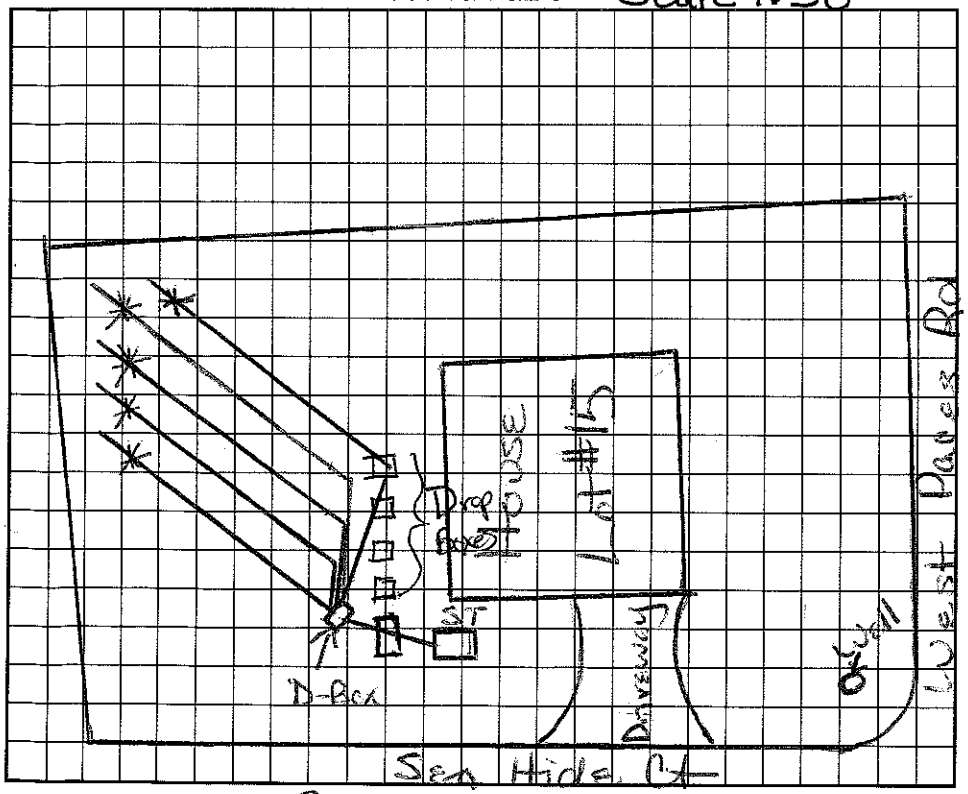

AS BUILT SKETCH

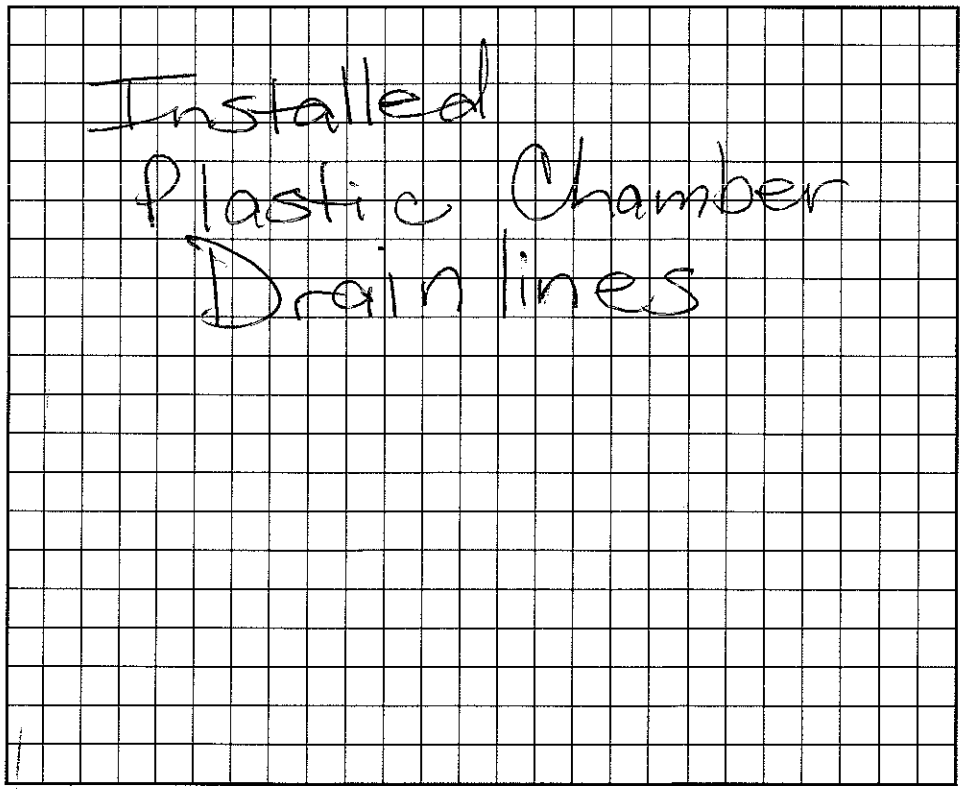

I understand that this permit can be suspended or revoked if any false information is supplied toward securing the permit/any unauthorized changes are made to the site/any unauthorized changes are made in the installation of the system. Improvement Permit is valid for 60 months from date of issuance.

Signed: Jenny [illegible] Agent 8/5/97

Improvement Permit by: Maria H. H. Dolson date 7/9/97

Existing System Inspection by: Maria H. H. Dolson date 5/7/2001

Installed by: A-1 - Backhoe RS

Certificate of Completion by: Maria H. H. Dolson date 10/15/2001

Operation Permit by: Maria H. H. Dolson RS date 10/15/2001

Const. HEALTH DEPT., COPY: WHITE INSPECTION COPY (FINAL): GREEN OWNER COPY (FINAL): YELLOW INSPECTION COPY (INITIAL): PINK OWNER COPY (INITIAL): GOLD