IREDELL COUNTY HEALTH DEPARTMENT

STATESVILLE 704-878-5305 MOORESVILLE 704-664-5281

IMPROVEMENT PERMIT / CERTIFICATE OF COMPLETION / OPERATION PERMIT / EXISTING SYSTEM INSPECTION

PROPERTY DESCRIPTION NO 96641 DATE 7/1/97 TAX MAP NO. 4644481479 Pt 4644481789 Watershed: ☒ Yes ☐ No

OWNER OR CONTRACTOR Crescent Resources - RANDY CARRIKER PHONE: Business 663-6905 Home

ADDRESS P.O. Box 1003 Charlotte NC 28201

LOCATION Langtree TL Mecklenn TR on West Paces Rd

SUBDIVISION Westview BLOCK / SECTION LOT 8 LOT AREA 1.17 SITE CLASS. PS DESIGN FLOW 450gpd L.T.A.R. .3

Septic Tank: 1000 Gallons; STB 97 JAS Date 3-30-00

Pump Tank: 1000 Gallons; PT 1 JAS Date 4-10-00

Pump Make: Goulds Model WE0311 L Serial No.

Nitrification Field: No Fields 1 Square Feet 1617 Linear Feet 539'

No Lines 7 at 77' Trench Width 36" Max Trench Bottom Depth 36" Gravel Depth 12"

☒ New System ☐ Repair System Type: I, II, III, IV, V, VI

System Description: Pump - Conventional

Repair System Description: Modified

Maintenance Agreement Required: ☐ Yes ☒ No

☒ House/Mod. Home No. Bedrooms 4+1

☐ Mobile Home No. Bathrooms 3.5

☐ Business No. Employees

☐ Other


☐ Slab ☒ Crawl Space ☐ Basement w/plumbing ☐ Basement wo/plumbing

Water Supply: ☒ Individual ☐ Community ☐ Public


Comments: Reviewed building plans & site plan - in compliance with Improvement permit. Bonus Room - can not have closet, otherwise it will be counted as bedroom. MJ

Comments: Check Lines & Tanks 7-7-00 DRH. Pressure checked 7/13/00 Stand pipe in valve box on upper side of pressure manifold. (Home made manifold) Gate valve on lower side ☒ Check for rope on pump when before finaling.

INITIAL SITE SKETCH Scale = 1:50

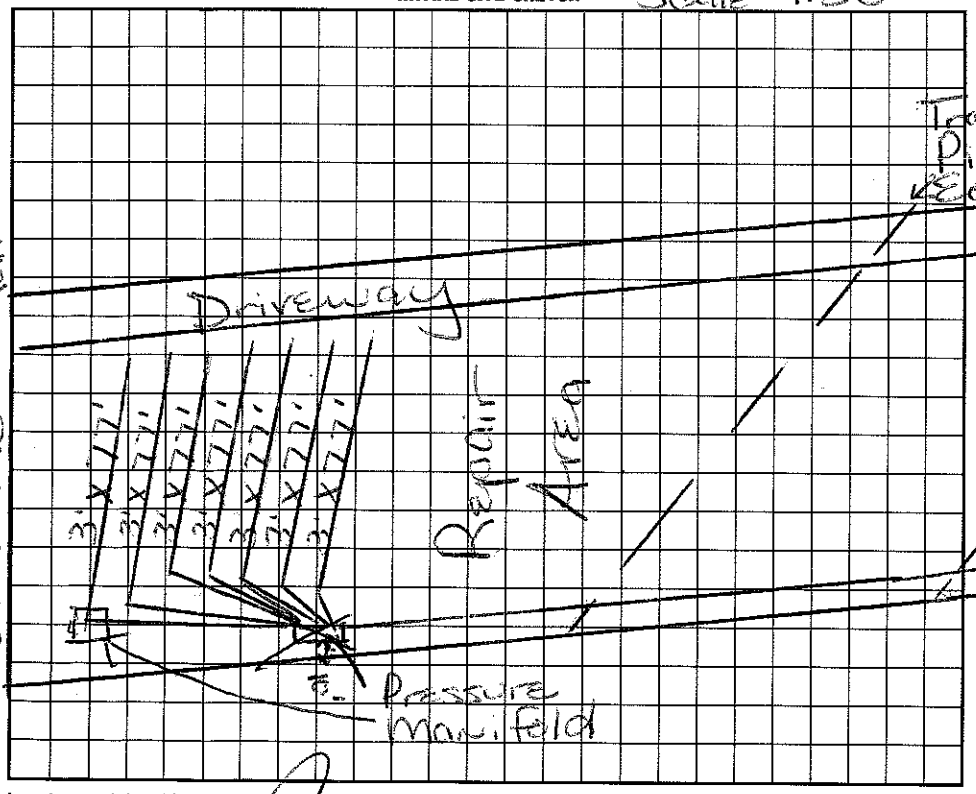

AS BUILT SKETCH

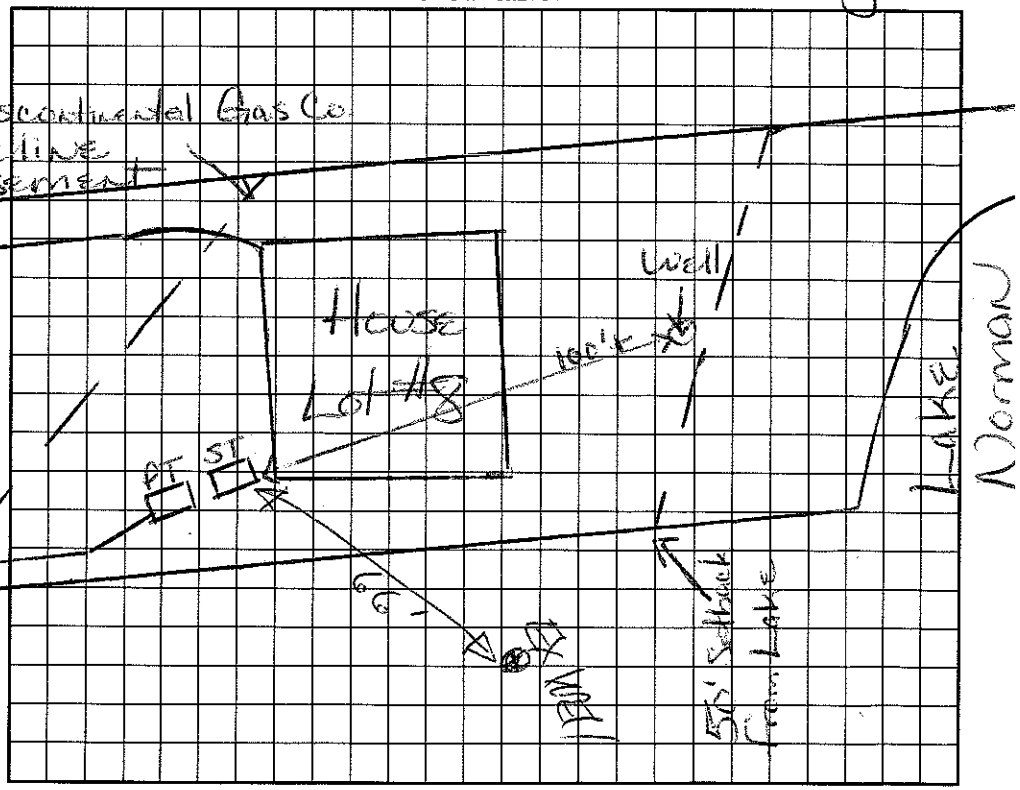

I understand that this permit can be suspended or revoked if any false information is supplied toward securing the permit/any unauthorized changes are made to the site/any unauthorized changes are made in the installation of the system. Improvement Permit is valid for 60 months from date of issuance.

Signed: [signature] 8/5/97

Improvement Permit by: Maria H. Dotson RS date 7/1/97

Existing System Inspection by: Maria H. Dotson RS date 11/9/99

Installed by: Robert Lawey Septic 289-2249

Certificate of Completion by: Maria H. Dotson RS date 8/30/2000

Operation Permit by: date

Const. Auth.

HEALTH DEPT. COPY: WHITE INSPECTION COPY (FINAL): GREEN OWNER COPY (FINAL): YELLOW INSPECTION COPY (INITIAL): PINK OWNER COPY (INITIAL): GOLD