IREDELL COUNTY HEALTH DEPARTMENT

STATESVILLE 704-878-5305 MOORESVILLE 704-664-528

IMPROVEMENT PERMIT / AUTHORIZATION TO CONSTRUCT / OPERATION PERMIT / EXISTING SYSTEM INSP

PERMIT# 06486 / 126670 PIN# ~~4644448147911~~ 4644-49-3000 2nd DATE 1-10-06

OWNER OR CONTRACTOR Dirk Newsome PHONE: Business Dewey Saunders 4993 Home

ADDRESS 126 West Paces Rd Mooresville

LOCATION Langtree IL Mecklynn IR West Paces Rd on Right

SUBDIVISION Westview BLOCK / SECTION LOT 6 LOT AREA .95 Acre SITE CLASS P5 DESIGN FLOW 480 gpd L.T.A.R. .3

Septic Tank: 1000 Gallons; STB 1012 Date 11/15/05
Pump Tank: 1000 Gallons; PT 19 Date 3/7/06
Pump Make: Gould Model WE0-511 Serial No.
Nitrification Field: No Fields 1 Square Feet 540' Linear Feet 270'
No Lines 4 Trench Width 24" Max Trench Bottom Depth 30-36" Gravel Depth N/A

☒ New System ☐ Repair System Type: I, II, III, IV, V, VI
System Description: Pump (LP) Panel Block
Repair System Description: Same
Maintenance Agreement Required: ☒ Yes ☐ No


☒ House/Mod. Home No. Bedrooms 4
☐ Mobile Home No. Bathrooms 6.5
☐ Business No. Employees
☐ Other
☐ Slab ☐ Crawl Space ☒ Basement w/plumbing ☐ Basement wo/plumbing

Water Supply: ☒ Individual ☐ Public ☐ Community


Comments:/Conditions: Keep Septic System at least 10' to PL, 50' from lake & (required setback) out of Transcontinental Pipeline Right of Way.

Comments:/Conditions: Run water line opposite side of Septic Supply line. Keep "Future pool" at least 15' from ST & PT
Measure Bedroom Panel Lines

INITIAL SITE SKETCH Scale 1:50

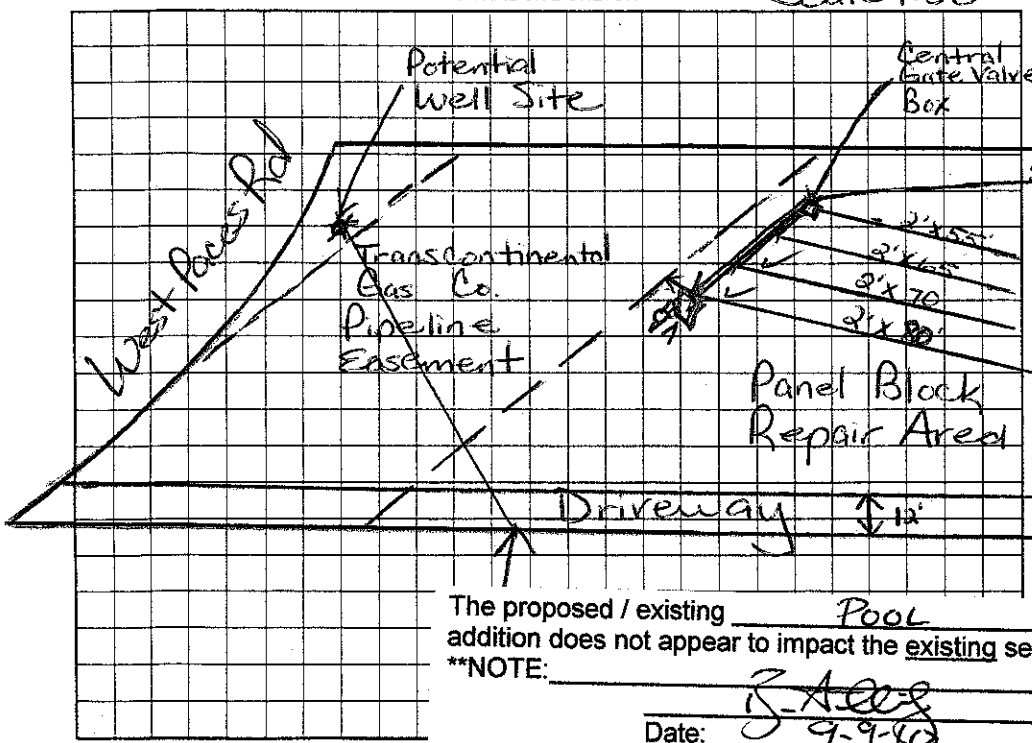

AS BUILT SKETCH 8-18-06

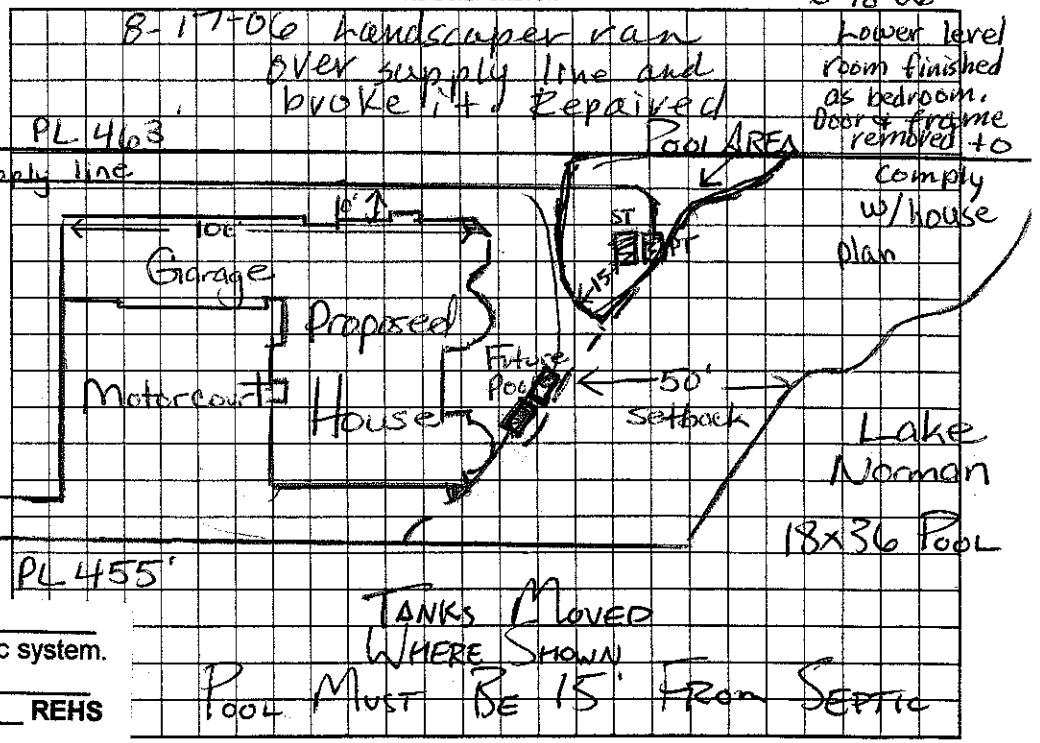

The proposed / existing Pool addition does not appear to impact the existing septic system.
**NOTE:

REHS
Date: 9-9-10
ICHD-Environmental Health Division

Permit can be suspended or revoked if an ade to the site/any unauthorized changes are made in the installation of the system. Improvement Permit with plat valid without expiration. Improvement Permit with site plan valid for sixty months. Authorization to Construct is valid for a period equal to that of Improvement Permit – not to exceed sixty months.

Signed: date 2/2/05 Installed by: C+S

Improvement Permit by: Maria H. Dolan R.S. date 1/28/05 Operation Permit by: Judy Melilli date 8-22-06

Authorization to Construct by: Maria H. Dolan R.S. date 1/28/05 Existing System Inspection by: date

HEALTH DEPT. COPY: WHITE OWNER COPY (FINAL): YELLOW OWNER COPY (INITIAL): PINK