IREDELL COUNTY HEALTH DEPARTMENT

STATESVILLE 704-878-5305 130.00 Paid MOORESVILLE 704-664-5281

IMPROVEMENT PERMIT / AUTHORIZATION TO CONSTRUCT / OPERATION PERMIT / EXISTING SYSTEM INSPECTIO

PERMIT# 18890 PIN# ~~4644999444 I, II~~ 4644888979 DATE 4/30/07

OWNER OR CONTRACTOR BURKE BUILDERS LLC PHONE: Business 391-0047 Home

ADDRESS PO BOX 3481 MOORESVILLE NC 28115

LOCATION 115(S) - TR BRIDGES FARM - TR CLOVERBANK - AT END

SUBDIVISION ESTATES BLOCK / SECTION LOT 11 LOT AREA .83AC SITE CLASS. PS DESIGN FLOW 480GPD L.T.A.R. .36AC/FT 2

Septic Tank: 1000 Gallons; STB 794 Date 3-12-07

Pump Tank: 1000 Gallons; PT 263 Date 3-02-07

Pump Make: Gravels Model ~~GP~~ P650 Serial No.

Nitrification Field; No Fields 1 Square Feet 1200 Linear Feet 400

No Lines 4 Trench Width 36" Max Trench Bottom Depth 36" Gravel Depth

☑ New System ☐ Repair System Type: I, II, III, IV, V, VI LPP

System Description: ~~PUMP 2500 GALLON~~ LP PANEL

Repair System Description: LP PANEL

Maintenance Agreement Required: ☐ Yes ☑ No

☑ House/Mod. Home No. Bedrooms 4

☐ Mobile Home No. Bathrooms 4

☐ Business No. Employees

☐ Other


☐ Slab ☑ Crawl Space ☐ Basement w/plumbing ☐ Basement wo/plumbing

Water Supply: ☑ Individual ☐ Public ☐ Community


Comments:/Conditions: DO NOT CUT HOUSE SITE - SITE VISIT REQUIRE BEFORE A/C TO BE ISSUED - DO NOT DISTURB SEPTIC OR REPAIR AREA WITH ROAD CUT OR EROSION CONTROL - ROAD NOT CUT IN AT TIME OF EVALUATION

Comments:/Conditions: * Well Variance Issued By NCDENR attached with file

INITIAL SITE SKETCH

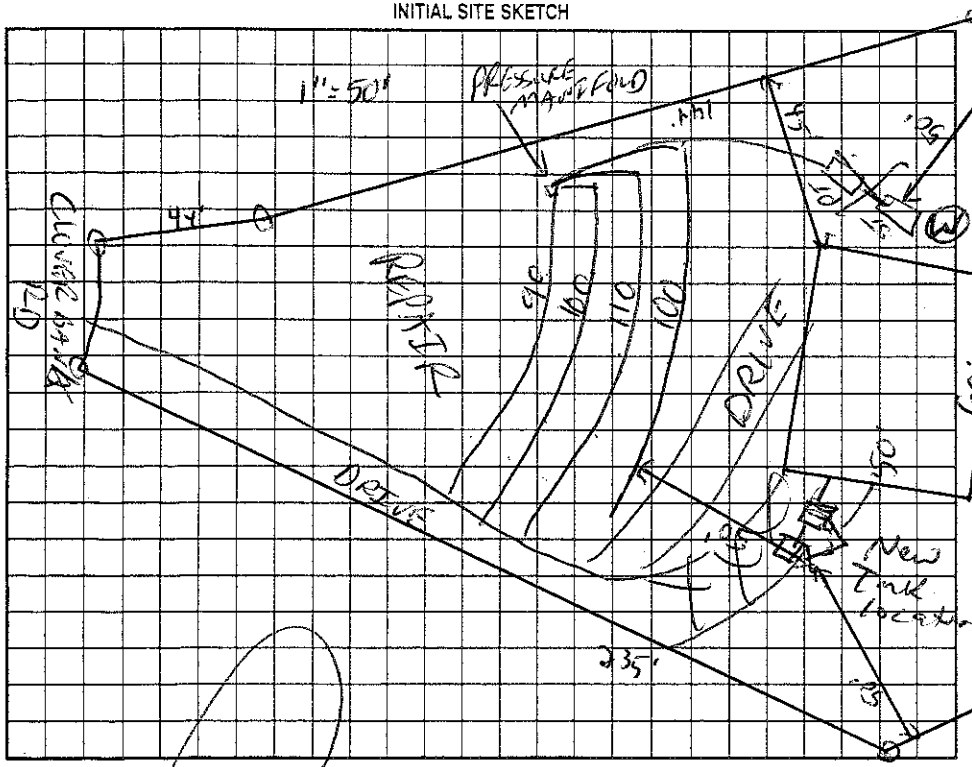

AS BUILT SKETCH

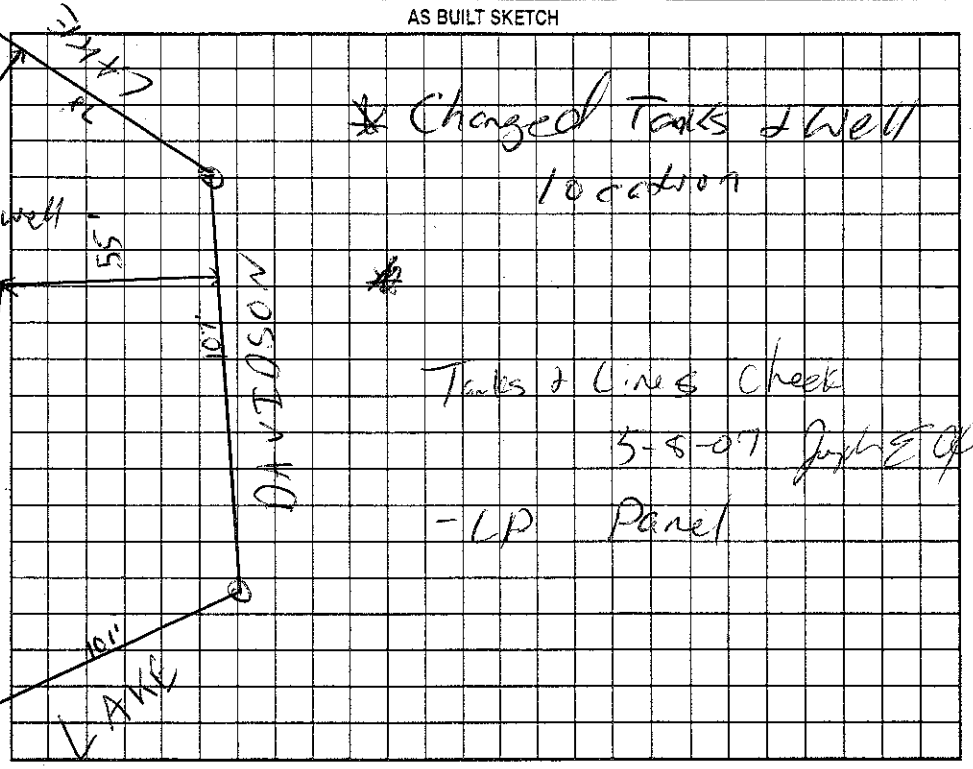

Permit can be suspended or revoked if any false information is supplied toward securing the permit/any unauthorized changes are made to the site/any unauthorized changes are made in the installation of the system. Improvement Permit with plat valid without expiration. Improvement Permit with site plan valid for sixty months. Authorization to Construct is valid for a period equal to that of Improvement Permit – not to exceed sixty months.

Signed: date 5-11-04 Installed by: Bobby McCarver

Improvement Permit by: date 4/30/07 Operation Permit by: date 6-18-07

Authorization to Construct by: date 6/5/06 Existing System Inspection by: date

HEALTH DEPT. COPY: WHITE OWNER COPY (FINAL): YELLOW OWNER COPY (INITIAL): PINK