IREDELL COUNTY HEALTH DEPARTMENT

STATESVILLE 704-878-5305 MOORESVILLE 704-664-5281

IMPROVEMENT PERMIT / AUTHORIZATION TO CONSTRUCT / OPERATION PERMIT / EXISTING SYSTEM INSPECTION

PERMIT# 14322721487 PIN# 4644-98-9827 DATE 6-16-07

OWNER OR APPLICANT BOB RUDISILL HOMES, INC PHONE: Business 704-662-3468 Home 704-450-0377

ADDRESS 174 WINDING SHORE DRIVE TROUTMAN NC 28166

LOCATION NC 115 SOUTH, TR BRIAGES FARM ROAD, TR ~~CLARKSBURG~~ JILLIANS LANE, LOT AT END ON RIGHT

SUBDIVISION CALADIUM POINT BLOCK / SECTION LOT 3 LOT AREA 0.51 ACRE SITE CLASS PS DESIGN FLOW 480 L.T.A.R. 0.30 GPD/FT²

Septic Tank: 1000 Gallons; STB Date

Pump Tank: Gallons; PT Date

Pump Make: Model Serial No.

Nitrification Field: No Fields 1 Square Feet EQ. TO 1600 Linear Feet 400

No Lines SEVEN Trench Width 36" Max Trench Bottom Depth 32"

☒ New System ☐ Repair ☐ Expansion System Type: I II III IV V VI

System Description: 25% REDUCTION, GRAVITY

Repair System Description: 50% REDUCTION, LOW-PRESS

Maintenance Agreement Required: ☐ Yes ☒ No

☒ House/Mod. Home No. Bedrooms 4

☐ Mobile Home No. Persons

☐ Business No. Employees

☐ Other


Water Supply: ☒ Individual ☐ Public ☐ Community

Gravel Depth N/A ☒ Gravity ☐ Pressure ☐ Slab ☐ Crawl Space ☐ Basement w/plumbing ☐ Basement wo/plumbing


Comments:/Conditions: ① KEEP SYSTEM MAXIMUM FEASIBLE DISTANCE (65') FROM WELLS ② INSTALL 25% REDUCTION SYSTEM ON CONTOUR AS SHOWN NO DEEPER THAN 32", USING SERIAL DISTRIBUTION

Comments:/Conditions:

INITIAL SITE SKETCH

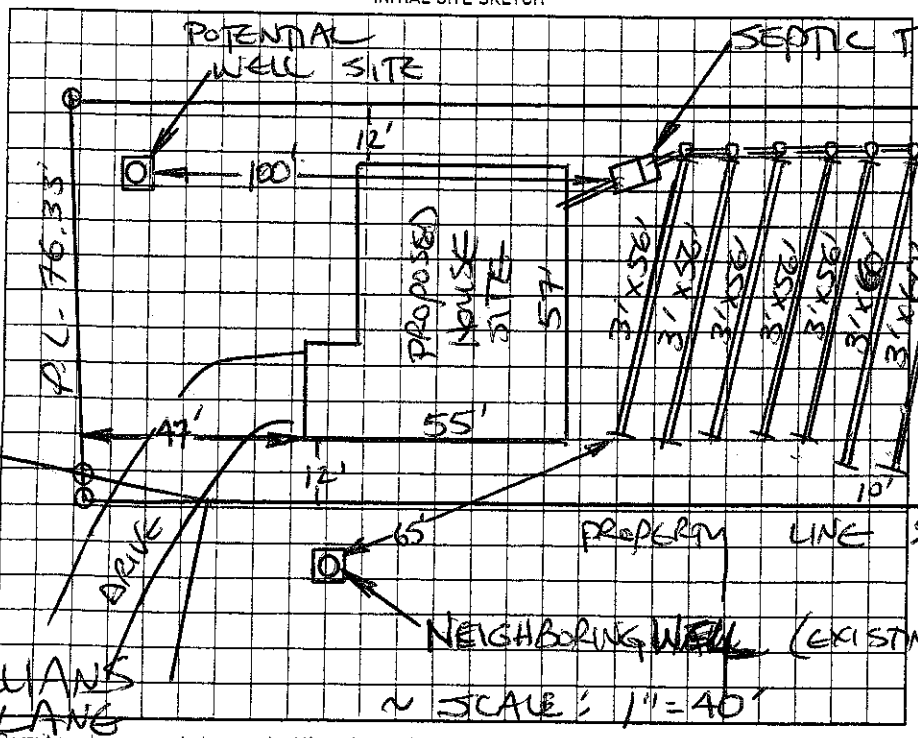

AS BUILT SKETCH

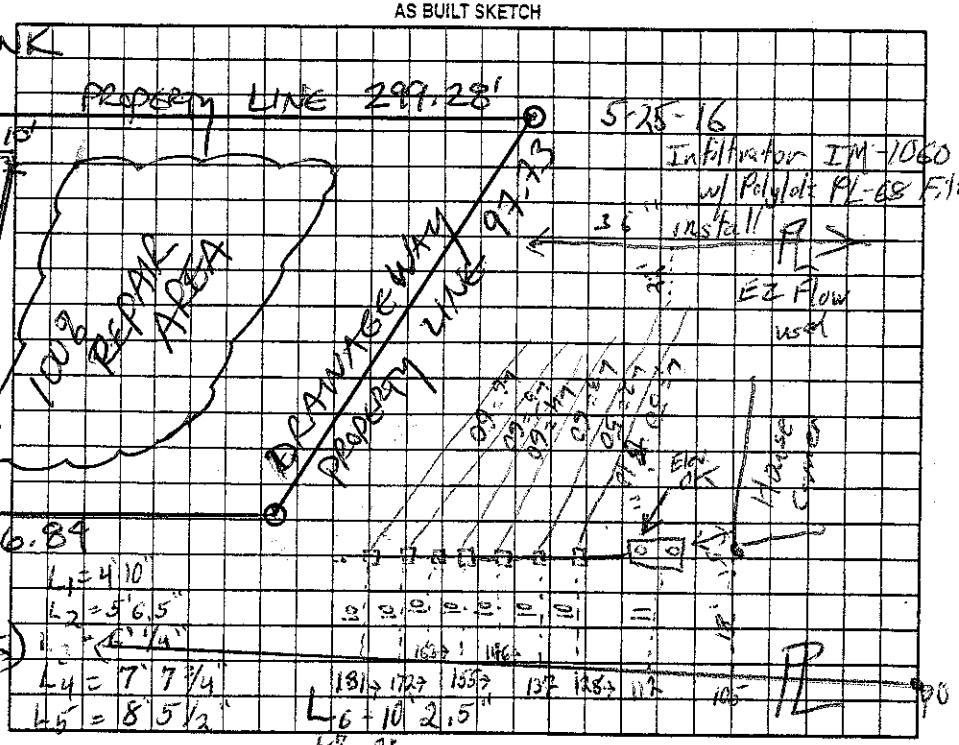

Permit can be suspended or revoked if any false information is supplied toward securing the permit/any unauthorized changes are made to the site/any unauthorized changes are made in the installation of the system. Improvement Permit with plat valid without expiration ☐ Improvement Permit with site plan valid for sixty months ☒ Authorization to Construct is valid for a period equal to that of Improvement Permit – not to exceed sixty months.

Signed: Agent date 6-25-07 Installed by: Rhaes Backoe + Septic

Improvement Permit by: STEVE HEDRICK date 6-16-07 Operation Permit by: Tom Shuck date 5-25-16

Authorization to Construct by: APPROVED OCT 29 2015 Existing System Inspection by: date

HEALTH DEPT. COPY: WHITE OWNER COPY (FINAL): YELLOW OWNER COPY (INITIAL): PINK