IREDELL COUNTY HEALTH DEPARTMENT

STATESVILLE 704-878-5305 $130 MOORESVILLE 704-664-5281

IMPROVEMENT PERMIT / AUTHORIZATION TO CONSTRUCT / OPERATION PERMIT / EXISTING SYSTEM INSPECTION

PERMIT# 1188859 PIN# ~~4644 64 7447.10~~ 4644900041 DATE 4/23/04

OWNER OR CONTRACTOR BURNE BUILDERS PHONE: Business 391-0047 Home

ADDRESS PO BOX 3481 MOORESVILLE, NC 28115

LOCATION 115(S) - TR BRIDGES FARM - TR CLOVER BANK - O.N LT

SUBDIVISION ESTATES BLOCK / SECTION LOT 10 LOT AREA .58AC SITE CLASS PS DESIGN FLOW 360GPD L.T.A.R. .3600 FT²

Septic Tank: 1000 Gallons; STB 1312 Date 11-28-06
Pump Tank: 1000 Gallons; PT 233 Date 10-23-06
Pump Make: ~~Geo~~ Model ~~Geo~~ Serial No. ~~20~~
Nitrification Field: No Fields 1 Square Feet ~~900~~ Linear Feet ~~300~~
No Lines 4@50' Trench Width 36" Max Trench Bottom Depth 36" Gravel Depth N/A

☑ New System ☐ Repair System Type I, II, III, IV, V, VI
System Description: ~~PUMP 25% REDUCTION~~
Repair System Description: LP PANEL
Maintenance Agreement Required: ☑ Yes ~~☐ No~~


☑ House/Mod. Home No. Bedrooms 3
☐ Mobile Home No. Bathrooms 3
☐ Business No. Employees
☐ Other

☐ Slab ☑ Crawl Space ☐ Basement w/plumbing ☐ Basement wo/plumbing


Water Supply: ☑ Individual ☐ Public ☐ Community

Comments:/Conditions: 1) DO NOT ISSUE A/C BEFORE VISITING SITE - 2) CHECK FOR ROAD CUT & SILT PONDS. 3) PERMIT WILL BE VOIDED IF SEPTIC AREA OR REPAIR COMPROMISED. 3) ROAD NOT CUT IN AT TIME OF EVALUTION.

INITIAL SITE SKETCH 1" = 50'

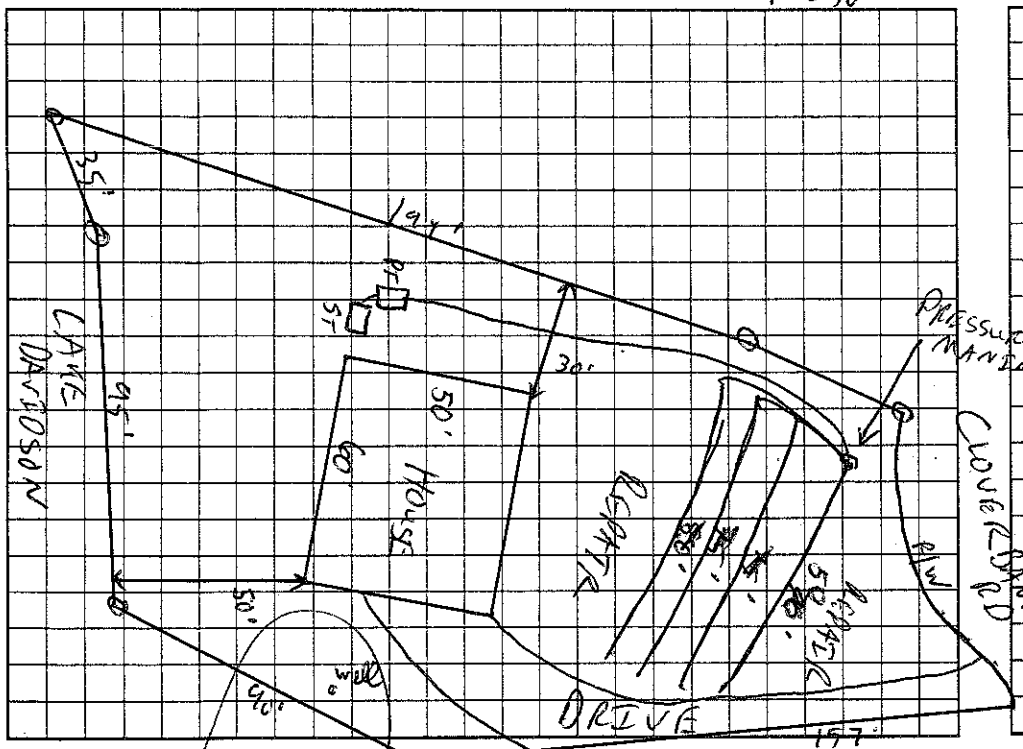

AS BUILT SKETCH

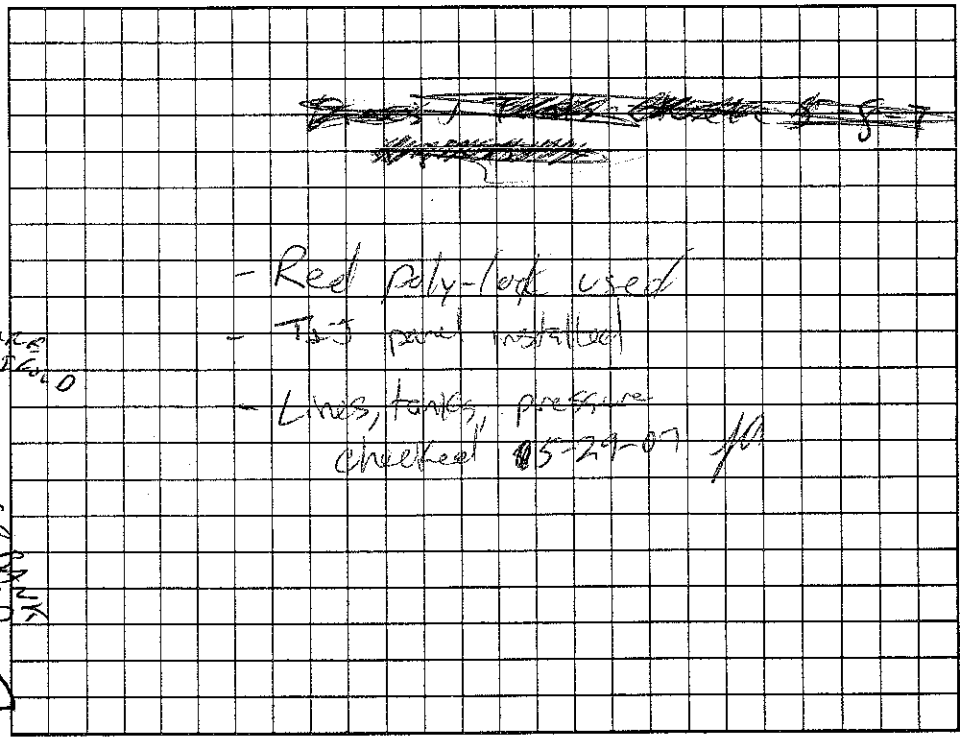

Permit can be suspended or revoked if any false information is supplied toward securing the permit/any unauthorized changes are made to the site/any unauthorized changes are made in the installation of the system. Improvement Permit with plat valid without expiration. Improvement Permit with site plan valid for sixty months. Authorization to Construct is valid for a period equal to that of Improvement Permit – not to exceed sixty months.

Signed: date Installed by: Bobby McCarver

Improvement Permit by: date 4/23/04 Operation Permit by: date 6-18-07

Authorization to Construct by: date 11/28/06 Existing System Inspection by: date

HEALTH DEPT. COPY: WHITE OWNER COPY (FINAL): YELLOW OWNER COPY (INITIAL): PINK