10:30

IREDELL COUNTY HEALTH DEPARTMENT

STATESVILLE 704-878-5305 MOORESVILLE 704-664-5281

IMPROVEMENT PERMIT / AUTHORIZATION TO CONSTRUCT / OPERATION PERMIT / EXISTING SYSTEM INSPECTION

PERMIT# 18877 PIN# ~~4644-99-7447.8~~ 4644992033 DATE 4/23/04

OWNER OR CONTRACTOR BURKE BUILDERS / MONOGRAM HOMES PHONE: Business 361-0047 Home

ADDRESS PO BOX 3481 MOORESVILLE NC 28115

LOCATION 115(S) - JR BRIDGES FARM - ON LJ.

SUBDIVISION ESTATES BLOCK / SECTION LOT 8 LOT AREA .59AC SITE CLASS. PS DESIGN FLOW 360GPD L.T.A.R. .2600/FT2

Septic Tank: 1000 Gallons; STB 312 Date 4/26/05
Pump Tank: 1000 Gallons; PT 27 Date 4/29/05
Pump Make: Goulds Model WE50311M Serial No.
Nitrification Field: No Fields 1 Square Feet 1350 Linear Feet 450
No Lines 5 @ 90' Trench Width 36" Max Trench Bottom Depth 18" Gravel Depth N/A

☑ New System ☐ Repair System Type: I, II, (III), IV, V, VI
System Description: PUMP 25% REDUCTION
Repair System Description: LPP
Maintenance Agreement Required: ☐ Yes ☑ No


☑ House/Mod. Home No. Bedrooms 3
☐ Mobile Home No. Bathrooms 3
☐ Business No. Employees
☐ Other
☐ Slab ☑ Crawl Space ☐ Basement w/plumbing ☐ Basement wo/plumbing

Water Supply: ☑ Individual ☐ Public ☐ Community


Comments:/Conditions: SITE VISIT REQUIRED BEFORE AC TO BE ISSUED - CHECK FOR ROAD CUT/SILT PONDS. IF ROAD CUT/SILT POND/DRAINAGE SYSTEMS

Comments:/Conditions: → DISTURB SYSTEM AREA - SEPTIC PERMIT WILL BE VOIDED!! ROAD NOT CUT IN AT TIME OF EVALUATION

INITIAL SITE SKETCH 1"=50'

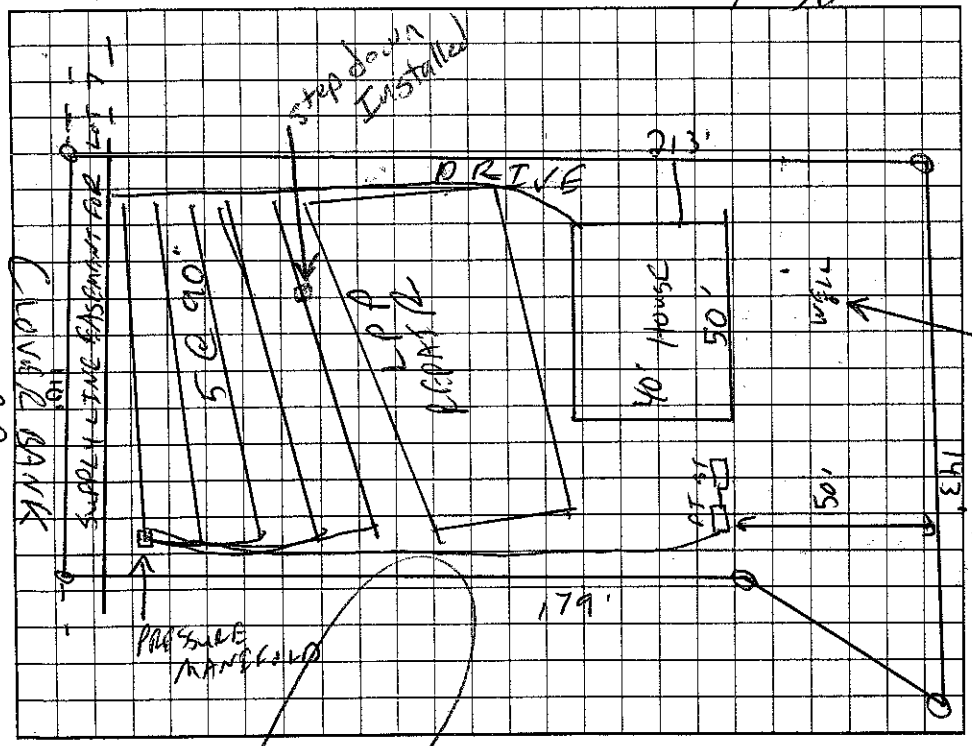

AS BUILT SKETCH

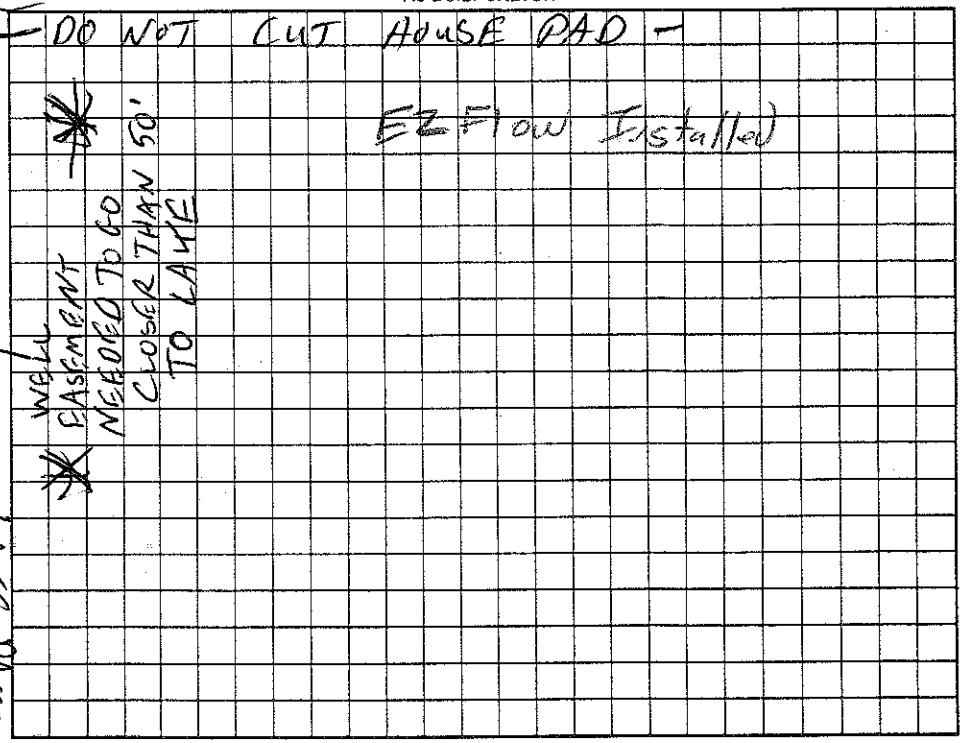

Permit can be suspended or revoked if any false information is supplied toward securing the permit/any unauthorized changes are made to the site/any unauthorized changes are made in the installation of the system. Improvement Permit with plat valid without expiration. Improvement Permit with site plan valid for sixty months. Authorization to Construct is valid for a period equal to that of Improvement Permit – not to exceed sixty months.

Signed: date 4/27/04 Installed by: Bobby McCarver

Improvement Permit by: date 4/23/04 Operation Permit by: RS date 6/16/05

Authorization to Construct by: date 4/23/04 Existing System Inspection by: date

HEALTH DEPT. COPY: WHITE OWNER COPY (FINAL): YELLOW OWNER COPY (INITIAL): PINK