IREDELL COUNTY HEALTH DEPARTMENT

STATESVILLE 704-878-5305 MOORESVILLE 704-664-5281

IMPROVEMENT PERMIT / AUTHORIZATION TO CONSTRUCT / OPERATION PERMIT / EXISTING SYSTEM INSPECTION

PERMIT# 18903 PIN# 4644997447.16 4644-99-2278 DATE 4/26/04

OWNER OR CONTRACTOR BURKE BUILDERS/MONOGRAM HOMES PHONE: Business 391-0047 Home

ADDRESS PO BOX 3481 MOORESVILLE NC 28115

LOCATION 115(S) - TR BRIDGES FARM - TR CLOVERBANK - ON LT

SUBDIVISION ESTATES BLOCK / SECTION LOT 16 LOT AREA .58AC SITE CLASS. PS DESIGN FLOW 360GPD L.T.A.R. .3600/Ft²

Septic Tank: 1000 Gallons; STB 312 Date 6/6/2006

Pump Tank: ~~1000~~ Gallons; PT Date

Pump Make: Model Serial No.

Nitrification Field: No Fields 1 Square Feet 400 Linear Feet 200

No Lines 4@50' Trench Width 24" Max Trench Bottom Depth 36" Gravel Depth N/A

☑ New System ☐ Repair System Type: I, II, III, IV, V, VI Panel

System Description: ~~GP Pump 2@50' Gravelless~~

Repair System Description: LP PANEL

Maintenance Agreement Required: ☐ Yes ☑ No

☐ House/Mod. Home No. Bedrooms 3@

☐ Mobile Home No. Bathrooms 3

☐ Business No. Employees

☐ Other


☐ Slab ☑ Crawl Space ☐ Basement w/plumbing ☐ Basement wo/plumbing

Water Supply: ☑ Individual ☐ Public ☐ Community


Comments:/Conditions: 1) DO NOT CUT HOUSE PAD. 2) SITE VISIT REQUIRED BEFORE AC TO BE ISSUED TO CHECK FOR EROSION CONTROL METHODS 3) ROAD NOT CUT AT TIME OF INSPECTION 4) DO

Comments:/Conditions: NOT COMPROMISE SEPTIC & REPAIR WITH EROSION CONTROL.

INITIAL SITE SKETCH 1"=50'

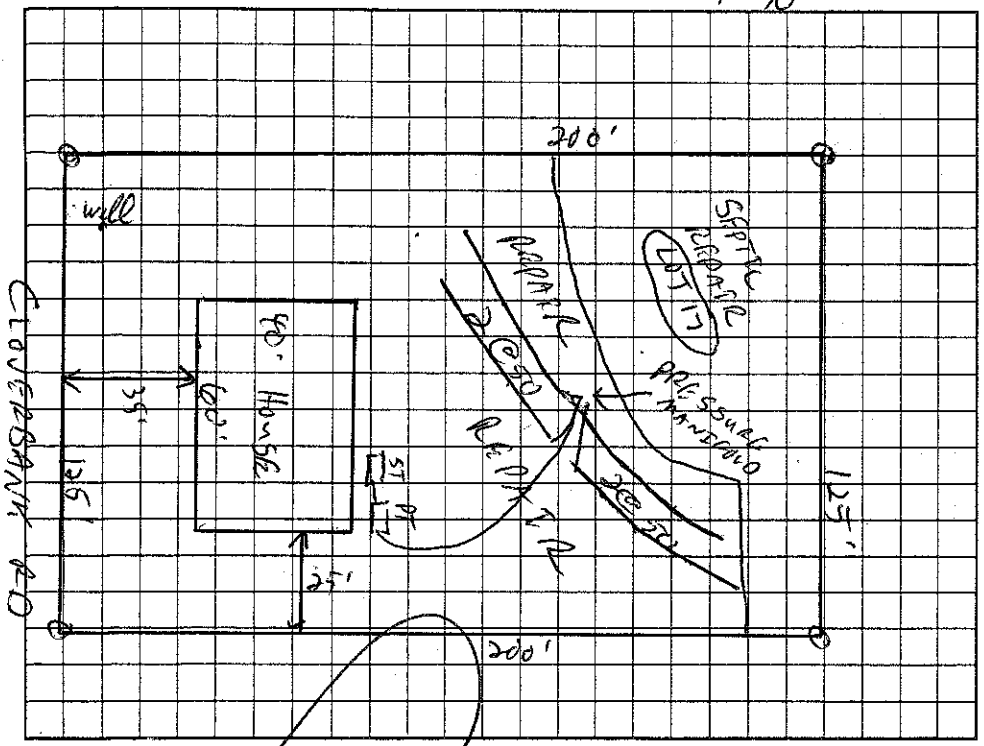

AS BUILT SKETCH

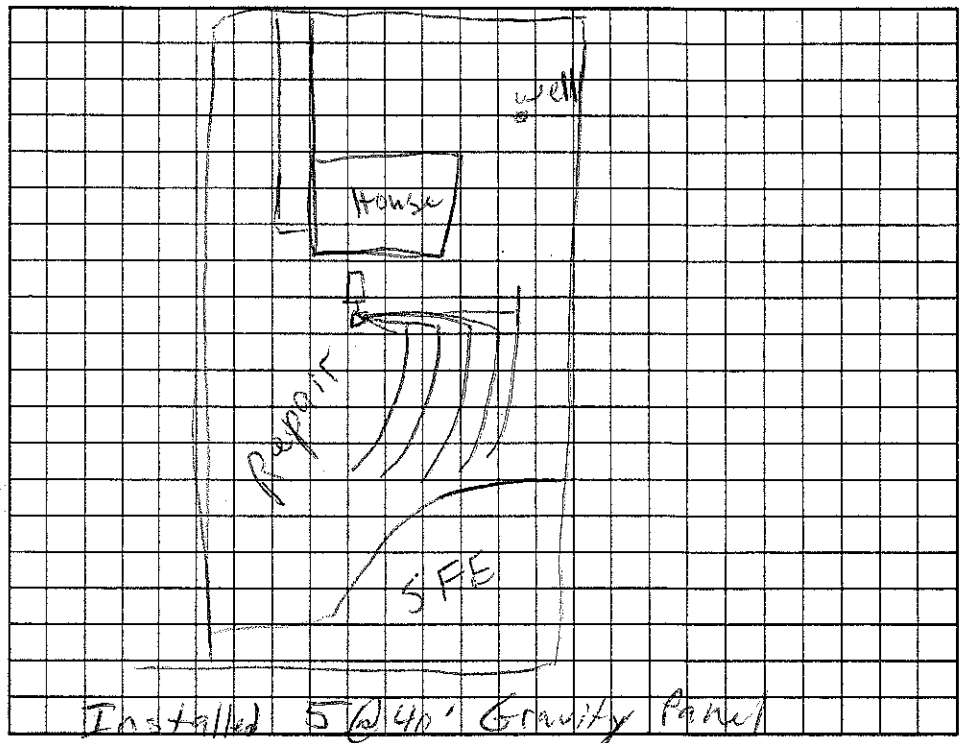

Permit can be suspended or revoked if any false information is supplied toward securing the permit/any unauthorized changes are made to the site/any unauthorized changes are made in the installation of the system. Improvement Permit with plat valid without expiration. Improvement Permit with site plan valid for sixty months. Authorization to Construct is valid for a period equal to that of Improvement Permit – not to exceed sixty months.

Signed: date 4/27/04 Installed by: McCarver

Improvement Permit by: RS date 4/26/04 Operation Permit by: RS date 9/22/06

Authorization to Construct by: date 3/7/06 Existing System Inspection by: date

HEALTH DEPT. COPY: WHITE OWNER COPY (FINAL): YELLOW OWNER COPY (INITIAL): PINK