IREDELL COUNTY HEALTH DEPARTMENT

Statesville Office (704) 878-5305 Mooresville Office (704) 660-3625 PERMIT # 218002

IMPROVEMENT PERMIT / AUTHORIZATION TO CONSTRUCT / OPERATION PERMIT / EXISTING SYSTEM

PIN # 4644-99-2278

APPLICANT: JOSEPH PUMA APPLICANT ADDRESS: 158 CLOVERBANK RD., MOOR

SITE ADDRESS: SAME PHONE: ALT. PHONE:

SITE DIRECTIONS: 1155, TR BRIDGES FARM, TR CLOVER BANK, ON R

SUBDIVISION: ESTATES @ DAVIDSON LAKE SECTION: — LOT # 16 LOT AREA: .58 AC DESIGN FLOW: 360 L.T.A.R.: .3

Septic Tank	Ex. 1000	(gal)	STB		Date		☐ New System	☐ Repair	☐ Expansion	System Type: I II (III) IV V VI	☐ Residence	No. Bedrooms		Water Supply
Pump Tank		(gal)	PT		Date		System Description:		PANEL BLOCK		☐ Business	No. Persons		☒ Private
Pump Make		Model			Serial #		Repair System Description:		SAME		☒ Other	No. Employees		☐ Public
# Nitrification Fields		# Lines	EXISTING		Linear Ft:		Maintenance Agreement Required:		☐ YES	☒ NO	☐ Slab	☒ Crawl Space		☐ Community
Trench Width		Max. Trench Bottom Depth			Gravel Depth	—	☒ GRAVITY		☐ PRESSURE		☐ Basement w/plumbing		☐ Basement w/o plumbing	

Comments / Conditions:

DECK

INITIAL SITE SKETCH

SEE PLAN FROM MICHAEL ATHANAS & ASSOCIATES

AS BUILT SKETCH

Permit can be suspended or revoked if any false information is supplied toward securing the permit / any unauthorized changes are made to the site / any unauthorized changes are made in the installation of the system. **CONTACT A LOCATOR SERVICE PRIOR TO ANY EXCAVATION**


☐ **IMPROVEMENT PERMIT** *with plat valid without expiration.* ☐ **IMPROVEMENT PERMIT** *with site plan valid for 60 mos.* ☐ **AUTHORIZATION TO CONSTRUCT** *valid for period equal to IMPROVEMENT PERMIT--not to exceed 60 mo.*

Owner / Applicant Signature: Joseph Puma Date: 6-1-16 Installed by:

IMPROVEMENT PERMIT by: Date: OPERATION PERMIT by: Date:

AUTHORIZATION TO CONSTRUCT by: Date: Existing System Inspected by: Date: APPROVED MAY 27 2016

Health Dept. Copy - WHITE Applicant (Final Approval) - YELLOW Applicant (Conditional Approval) - PINK

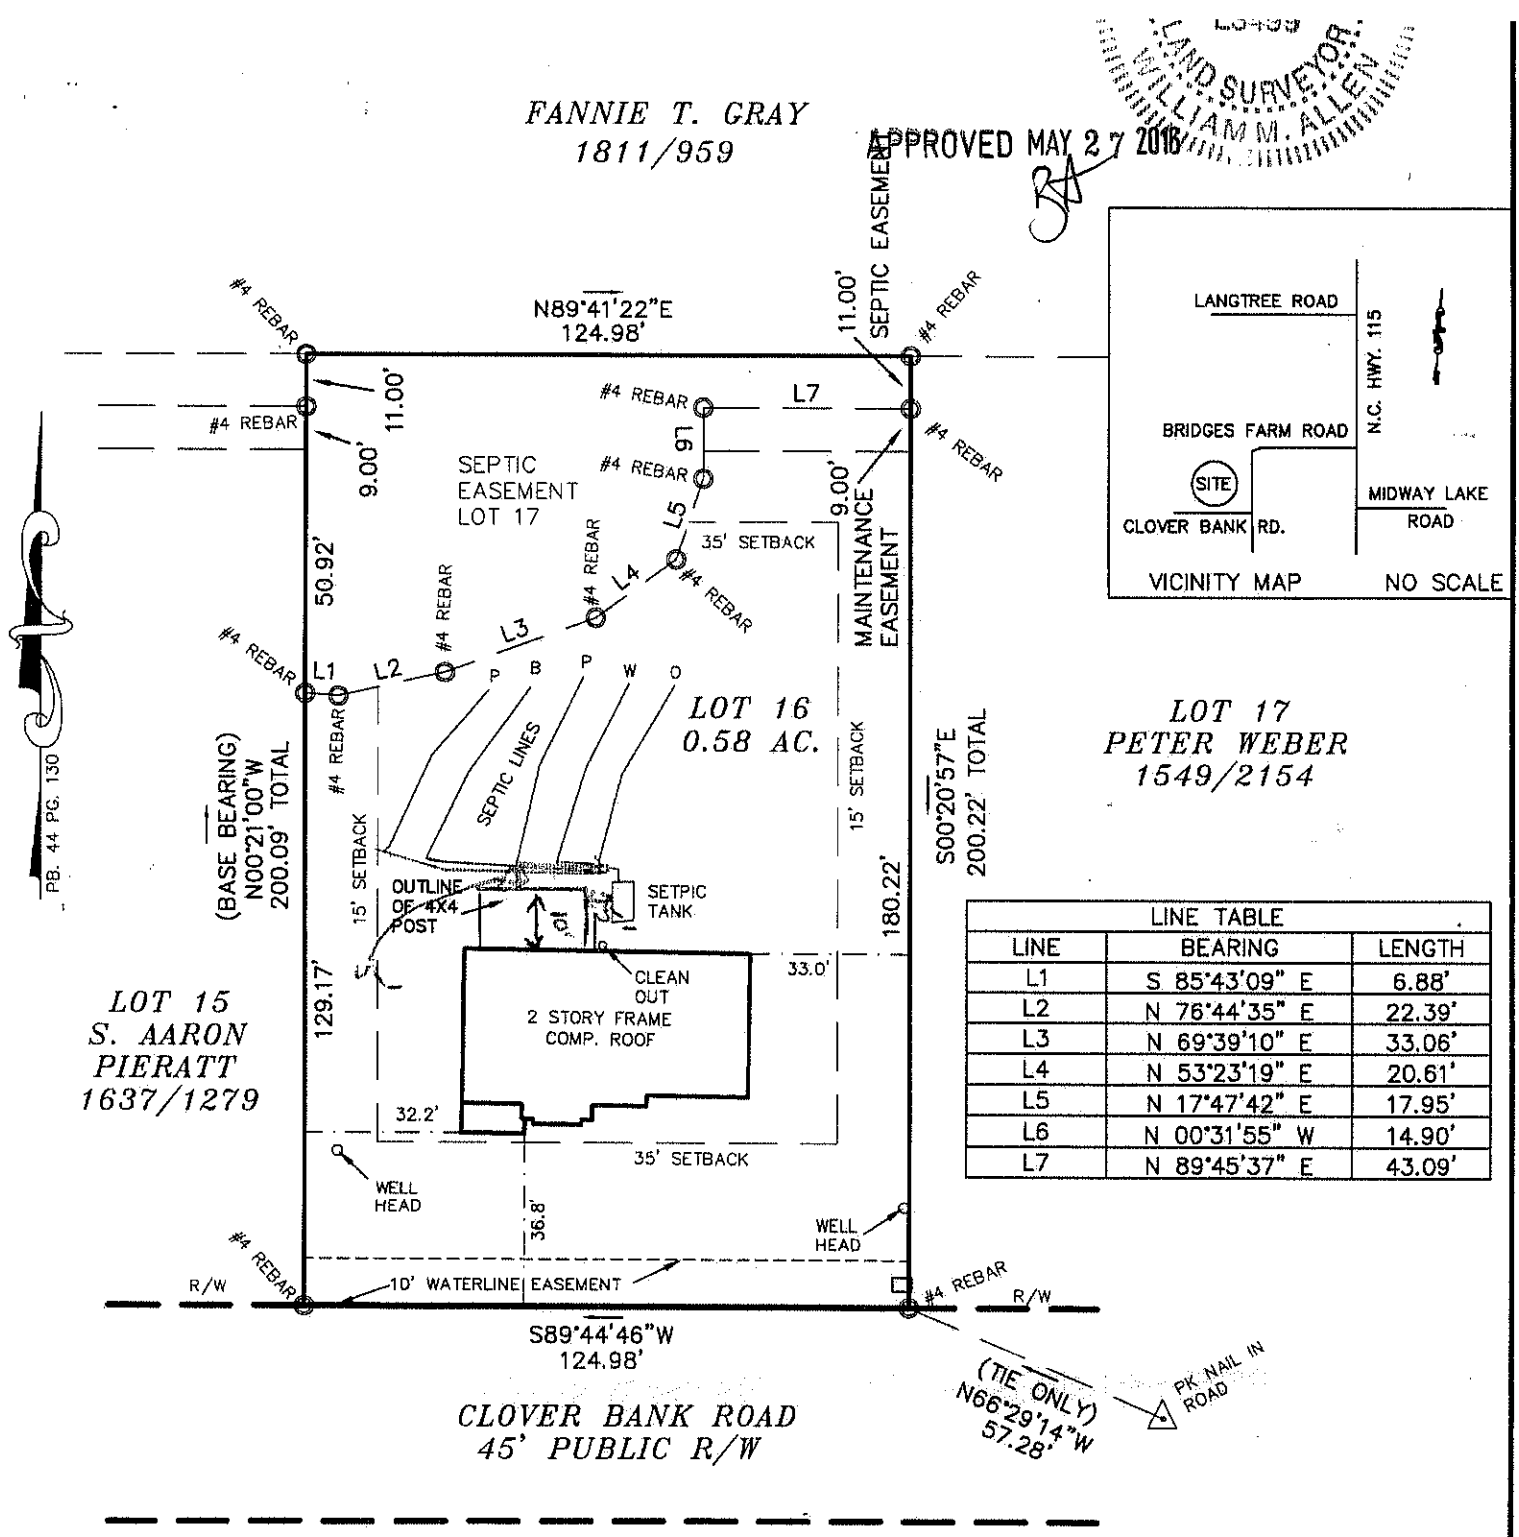

LINE TABLE		
LINE	BEARING	LENGTH
L1	S 85°43'09" E	6.88'
L2	N 76°44'35" E	22.39'
L3	N 69°39'10" E	33.06'
L4	N 53°23'19" E	20.61'
L5	N 17°47'42" E	17.95'
L6	N 00°31'55" W	14.90'
L7	N 89°45'37" E	43.09'

LEGEND
- □ = POWER TRANS.
- E.I.P. = EXISTING IRON FOUND
- I.P.S. = #4 REBAR SET
- R/W = RIGHT-OF-WAY
- Ⓦ = WELL

0' 20' 40' 100'

SCALE IN FEET

NOTES
1) THIS PROPERTY MAY BE SUBJECT TO ANY EASEMENTS AND/OR RIGHTS OF WAY OF RECORD.
2) ACREAGE COMPUTED BY THE COORDINATE METHOD.
3) UNDERGROUND POWER
4) NO GRID MONUMENT FOUND WITHIN 2000 FEET.

BOUNDARY / SEPTIC SURVEY

OF

158 CLOVER BANK ROAD

LOT 16 THE ESTATES AT DAVIDSON LAKE

SCALE 1" = 40'

DAVIDSON TWSP., IREDELL CO., N.C.

ACQUIRED BY: JOSEPH R. & LYNN B. PUMA

FIELD BOOK: 500K
FILE: ESTATES AT DAVIDSON 16
DC FILE:
TAX MAP NO: 4644992278