10:00

IREDELL COUNTY HEALTH DEPARTMENT

STATESVILLE 704-878-5305 MOORESVILLE 704-664-5281

IMPROVEMENT PERMIT / AUTHORIZATION TO CONSTRUCT / OPERATION PERMIT / EXISTING SYSTEM INSPECTION

PERMIT# 118905 PIN# ~~4644499 7447.17~~ 4644993298 DATE 4/26/04

OWNER OR CONTRACTOR BURKE BUILDERS / MENDENHALL HOMES PHONE: Business 391-0047 Home

ADDRESS PO BOX 3481 MOORESVILLE NC 28115

LOCATION 115(5) - TR BRIDGES FARM - TR CLOVERBANK - ON RT

SUBDIVISION ESTATES BLOCK / SECTION LOT 17 LOT AREA 1.58AC SITE CLASS. PS DESIGN FLOW 360GAD L.T.A.R. 360GAD/LTAR

Septic Tank: 1000 Gallons; STB 312 Date 3/12/05
Pump Tank: 1000 Gallons; PT 27 Date 3/19/05
Pump Make: SOLIDS Model NEOSYSTEM Serial No.
Nitrification Field: No Fields 1 Square Feet 440 Linear Feet 220
No Lines 3 Trench Width 24" Max Trench Bottom Depth 36" Gravel Depth N/A

☑ New System ☐ Repair System Type: I, II, III, IV, V, VI
System Description: LP PANEL OFFSITE
Repair System Description: SAME
Maintenance Agreement Required: ☑ Yes ☐ No


☑ House/Mod. Home No. Bedrooms 3
☐ Mobile Home No. Bathrooms 3
☐ Business No. Employees
☐ Other
☐ Slab ☑ Crawl Space ☐ Basement w/plumbing ☐ Basement wo/plumbing

Water Supply: ☑ Individual ☐ Public ☐ Community

Comments:/Conditions:


Comments:/Conditions: 1) A SITE VISIT REQUIRE BEFORE AC TO BE ISSUED - 2) CHECK FOR EROSION CONTROL METHODS. 3) ROAD NOT CUT IN AT TIME OF EVALUATION. 4) SOIL SHEETS ATTACHED TO LOT 15 & 16

INITIAL SITE SKETCH

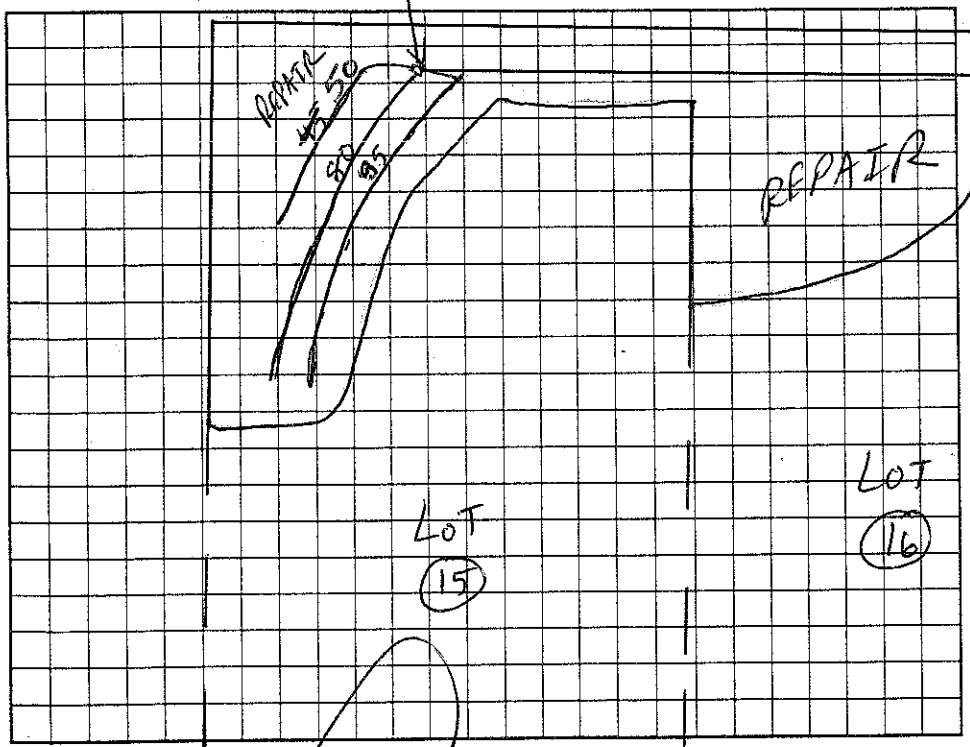

1" = 50'

AS BUILT SKETCH

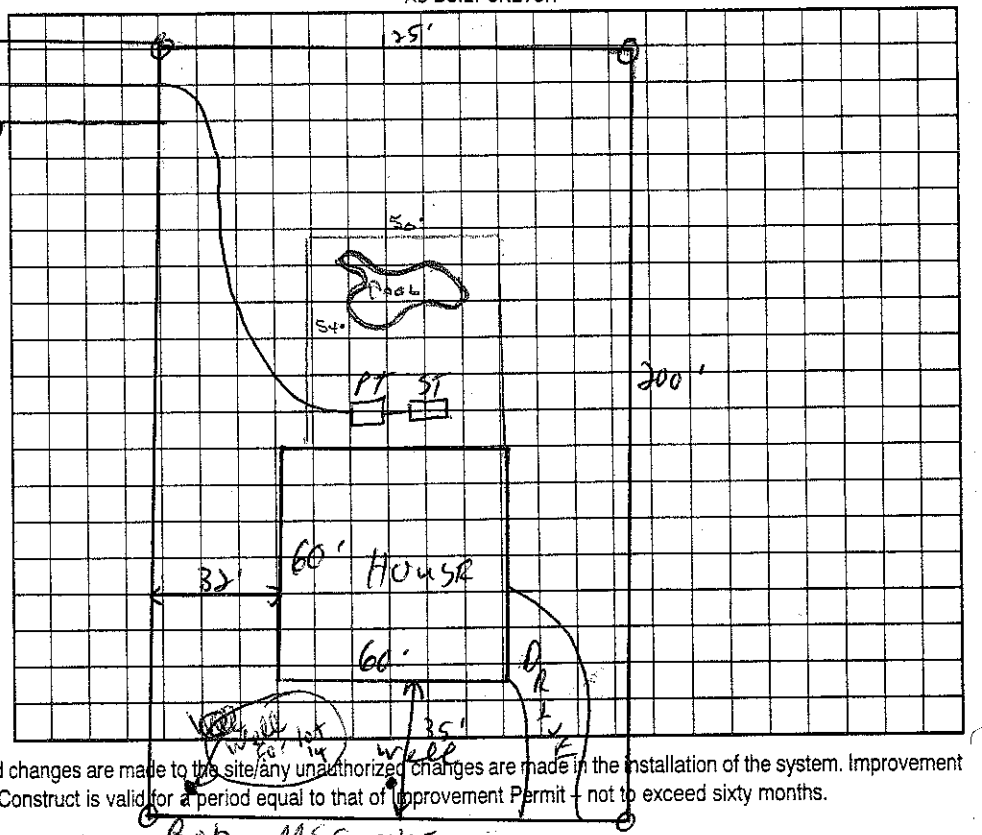

Permit can be suspended or revoked if any false information is supplied toward securing the permit/any unauthorized changes are made to the site/any unauthorized changes are made in the installation of the system. Improvement Permit with plat valid without expiration. Improvement Permit with site plan valid for sixty months. Authorization to Construct is valid for a period equal to that of Improvement Permit - not to exceed sixty months.

Signed: date 4/27/04 Installed by: Bob McCarver

Improvement Permit by: CHRIS date 4/26/04 Operation Permit by: RS date 5/24/05

Authorization to Construct by: CHRIS date 12/5/07 Existing System Inspection by: date

HEALTH DEPT. COPY: WHITE OWNER COPY (FINAL): YELLOW OWNER COPY (INITIAL): PINK