IREDELL COUNTY HEALTH DEPARTMENT

STATESVILLE 704-878-5305 MOORESVILLE 704-664-5281

IMPROVEMENT PERMIT / AUTHORIZATION TO CONSTRUCT / OPERATION PERMIT / EXISTING SYSTEM INSPECTION

PERMIT# 118875 PIN# ~~4644-99-1417-6~~ 9644991084 DATE 4/23/04

OWNER OR CONTRACTOR BURKE BUILDERS PHONE: Business 361-0047 Home

ADDRESS PO BOX 3481 MOORESVILLE NC 28115

LOCATION 115(S) - IR BRIDGES FARM - IR CLOVERBANK - LOT ON RT - SEPTIC ON RT

SUBDIVISION ESTATES BLOCK / SECTION LOT 6 LOT AREA .58AC SITE CLASS. PS DESIGN FLOW 360GPD L.T.A.R. .36AC/FT2

Septic Tank: 1000 Gallons; STB 294 Date 6/20/05
Pump Tank: 1000 Gallons; PT 283 Date
Pump Make: Goulds Model WE07121H Serial No.
Nitrification Field: No Fields 1 Square Feet 420 Linear Feet 210
No Lines 3@70' Trench Width 24" Max Trench Bottom Depth 36" Gravel Depth N/A

☑ New System ☐ Repair System Type: I, II, III, IV, V, VI
System Description: LP PANEL OFFSITE
Repair System Description: SAME - OFFSITE
Maintenance Agreement Required: ☑ Yes ☐ No

☑ House/Mod. Home No. Bedrooms 3
☐ Mobile Home No. Bathrooms 3
☐ Business No. Employees
☐ Other
☐ Slab ☑ Crawl Space ☐ Basement w/plumbing ☐ Basement wo/plumbing

Water Supply: ☑ Individual ☐ Public ☐ Community


Comments:/Conditions: IF ROAD CUT DISTURBS FRONT OF LOT - SEPTIC PERMIT WILL BE VOIDED.
- REQUIRED SITE VISIT BEFORE AC ISSUED TO CHECK FOR SILT POND AND ROAD CUT.

Comments:/Conditions: ROAD NOT CUT IN AT TIME OF EVALUATION - SILT PONDS/DRAINAGE NOT ESTABLISHED

INITIAL SITE SKETCH →


SEE MAP FOR EASEMENT AREA LOCATION.

1" = 100'

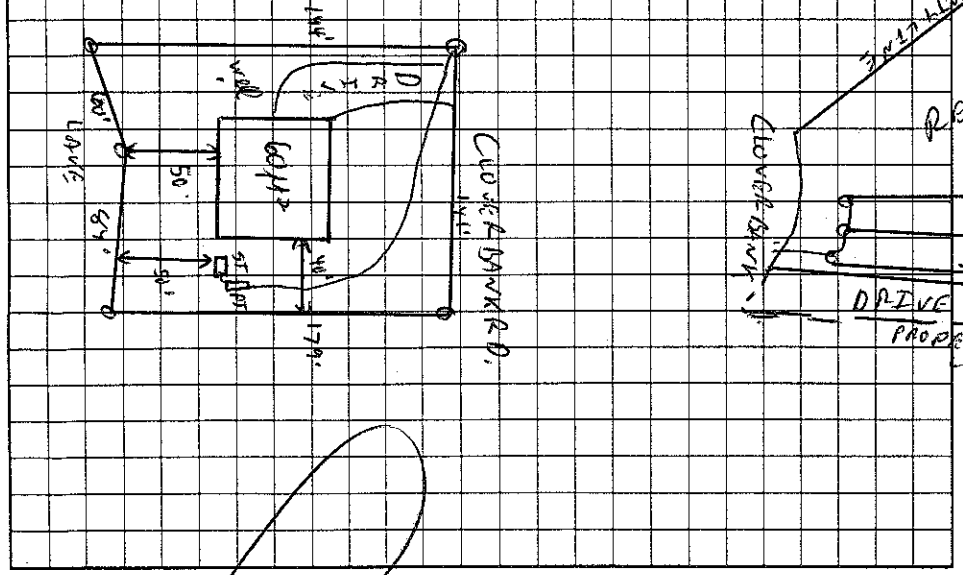

AS BUILT SKETCH

1" = 50'

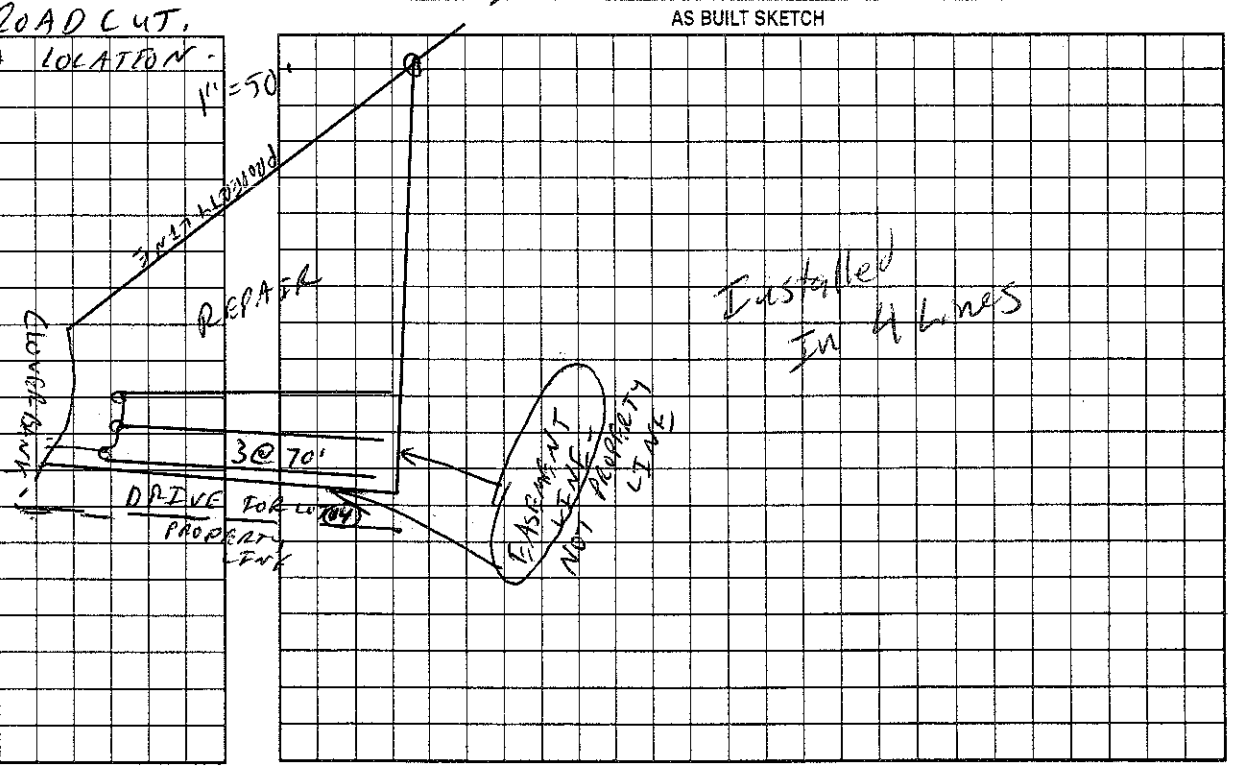

Permit can be suspended or revoked if any false information is supplied toward securing the permit/any unauthorized changes are made to the site/any unauthorized changes are made in the installation of the system. Improvement Permit with plat valid without expiration. Improvement Permit with site plan valid for sixty months. Authorization to Construct is valid for a period equal to that of Improvement Permit – not to exceed sixty months.

Signed: date 4/27/04 Installed by: McCarver

Improvement Permit by: RS date 4/23/04 Operation Permit by: RS date 3/29/06

Authorization to Construct by: RS date 8/17/05 Existing System Inspection by: date

HEALTH DEPT. COPY: WHITE OWNER COPY (FINAL): YELLOW OWNER COPY (INITIAL): PINK

