IREDELL COUNTY HEALTH DEPARTMENT

STATESVILLE 704-878-5305 MOORESVILLE 704-664-5281

IMPROVEMENT PERMIT / AUTHORIZATION TO CONSTRUCT / OPERATION PERMIT / EXISTING SYSTEM INSPECTION

PERMIT# 118908 PIN# 4644997447.19 4644996248 DATE 4/26/04

OWNER OR CONTRACTOR BURKE BUILDERS PHONE: Business 309-0047 Home

ADDRESS PO BOX 3481 MOORESVILLE NC 28115

LOCATION 115 (S) - TR BRIDGES FARM - TR CLOVERBANK RD - ON RT.

SUBDIVISION ESTATES BLOCK / SECTION LOT 19 LOT AREA .584c SITE CLASS. RS DESIGN FLOW 360GPD L.T.A.R. .250PD/FT²

Septic Tank: 1000 Gallons; STB 794 Date 11/29/04
Pump Tank: 1000 Gallons; PT 24 Date 11/29/04
Pump Make: Goulds Model WED311M Serial No.
Nitrification Field: No Fields 1 Square Feet 1080 Linear Feet 360
No Lines 4@90' Trench Width 36" Max Trench Bottom Depth 36" Gravel Depth

☑ New System ☐ Repair System Type: I, II, III, IV, V, VI
System Description: PUMP 25% REDUCTION
Repair System Description: LP PANEL
Maintenance Agreement Required: ☐ Yes ☑ No


☑ House/Mod. Home No. Bedrooms 3
☐ Mobile Home No. Bathrooms 3
☐ Business No. Employees
☐ Other
☐ Slab ☑ Crawl Space ☐ Basement w/plumbing ☐ Basement wo/plumbing

Water Supply: ☑ Individual ☐ Public ☐ Community


Comments:/Conditions: 1) DO NOT CUT HOUSE PAD. 2) SITE VISIT REQUIRED BEFORE A/C TO BE ISSUED TO CHECK FOR EROSION CONTROL METHODS 3) DO NOT COMPROMISE SEPTIC & REPAIR W/ EROSION CONTROL.

Comments:/Conditions: 4) ROAD NOT CUT AT TIME OF EVALUATION. Renewed Site plan & Floor plan 10/20/04; in compliance with original permit

INITIAL SITE SKETCH 1"=50'

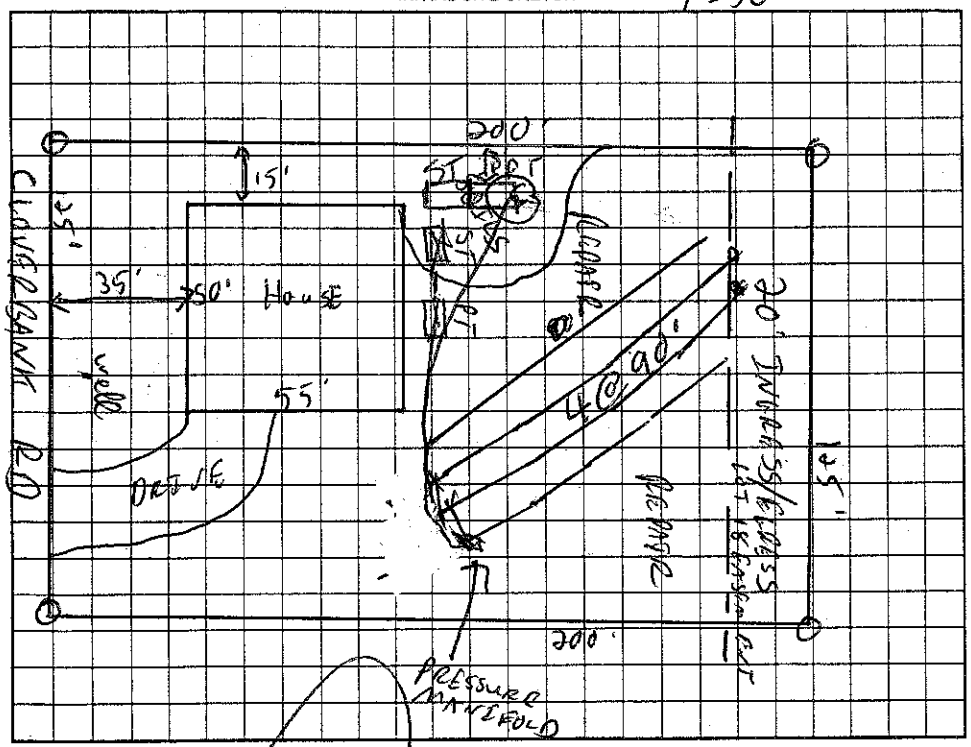

AS BUILT SKETCH

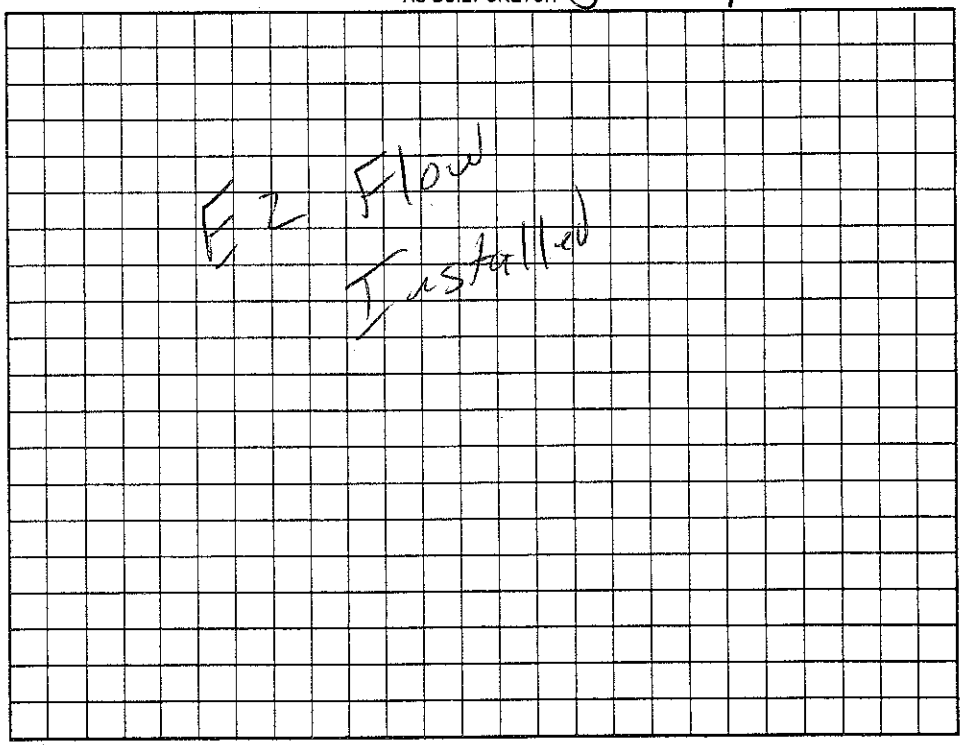

Permit can be suspended or revoked if any false information is supplied toward securing the permit/any unauthorized changes are made to the site/any unauthorized changes are made in the installation of the system. Improvement Permit with plat valid without expiration. Improvement Permit with site plan valid for sixty months. Authorization to Construct is valid for a period equal to that of Improvement Permit – not to exceed sixty months.

Signed: date 4/27/04 Installed by: Bob McCarver

Improvement Permit by: RS date 4/26/04 Operation Permit by: RS date 4/1/05

Authorization to Construct by: RS date 10/20/04 Existing System Inspection by: date

HEALTH DEPT. COPY: WHITE OWNER COPY (FINAL): YELLOW OWNER COPY (INITIAL): PINK