IREDELL COUNTY HEALTH DEPARTMENT

STATESVILLE 704-878-5305 130.00 Paid MOORESVILLE 704-664-5281

IMPROVEMENT PERMIT / AUTHORIZATION TO CONSTRUCT / OPERATION PERMIT / EXISTING SYSTEM INSPECTION

PERMIT# 118873 PIN# 4644997447.4 4644997064 DATE 4/30/04

OWNER OR CONTRACTOR Burke Builders PHONE: Business 361-0047 Home

ADDRESS PO Box 3481 - Mooresville NC 28115

LOCATION 115(S) - TR Bridges Farm - TR Clover Bank - ON LT.

SUBDIVISION Estates BLOCK / SECTION LOT 4 LOT AREA .55AC SITE CLASS PS DESIGN FLOW @ 360GPD L.T.A.R. .2 060 PKT

Septic Tank: 1000 Gallons; STB ~~288~~ 312 Date 5-20-06
Pump Tank: 1000 Gallons; PT 79 Date 4-1-06
Pump Make: Model Serial No.
Nitrification Field: No Fields 1 Square Feet 1350 Linear Feet 450
No Lines 4 Trench Width 36" Max Trench Bottom Depth (30") Gravel Depth N/A


☑ New System ☐ Repair System Type: I, II, III, IV, V, VI
System Description: Pump 25% Reduction
Repair System Description: LP Panel
Maintenance Agreement Required: ☐ Yes ☑ No

☑ House/Mod. Home No. Bedrooms 3
☐ Mobile Home No. Bathrooms 3
☐ Business No. Employees
☐ Other
☐ Slab ☑ Crawl Space ☐ Basement w/plumbing ☐ Basement wo/plumbing

Water Supply: ☑ Individual ☐ Public ☐ Community

Comments:/Conditions: 1) DO NOT CUT HOUSE SITE. 2) SITE VISIT REQUIRED BEFORE A/C TO BE ISSUED 3) DO NOT COMPROMISE SEPTIC AND/OR REPAIR WITH ROAD CUT OR EROSION CONTROL.

INITIAL SITE SKETCH

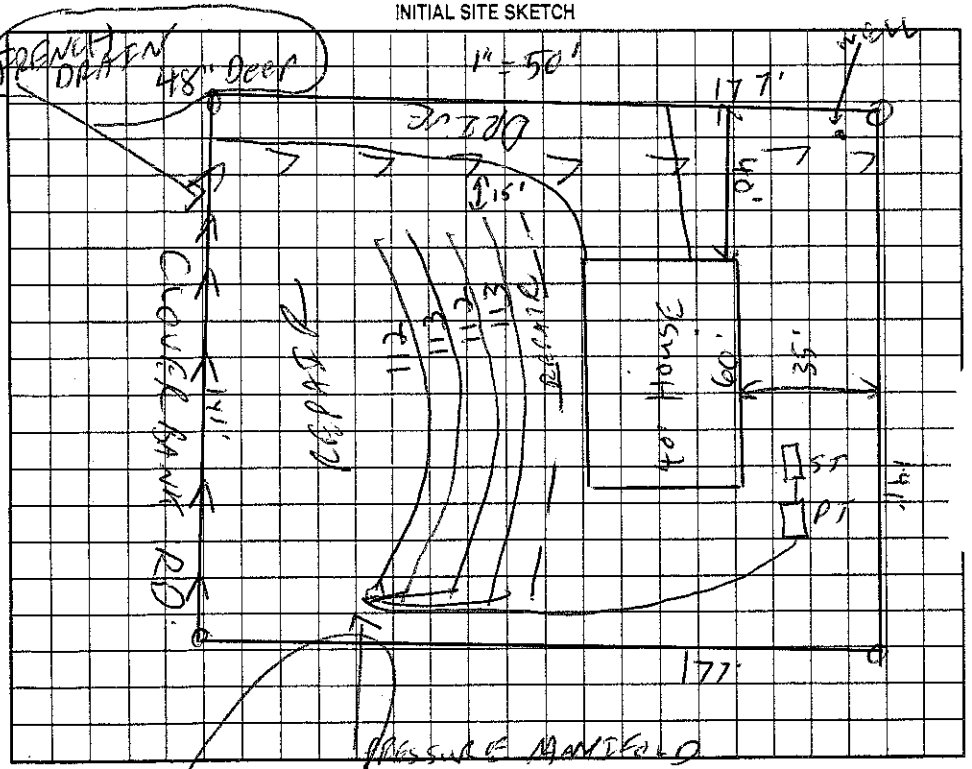

Comments:/Conditions: ROAD NOT CUT IN AT TIME OF EVALUATION
Red Polylok Filter

AS BUILT SKETCH

French drain not installed
EZ-Flow installed @ 36"
4 Lines @ 100' installed

The proposed / existing Deck addition does not appear to impact the existing septic system.
**NOTE: Do not expand foot print
5-A-06 REHS
Date: 5-3-06
ICHD-Environmental Health Division

Permit can be suspended or revoked if any false information is supplied toward securing the permit/any unauthorized changes are made to the site/any unauthorized changes are made in the installation of the system. Improvement Permit with plat valid without expiration. Improvement Permit with site plan valid for sixty months. Authorization to Construct is valid for a period equal to that of Improvement Permit – not to exceed sixty months.

Signed: date 5-11-04
Improvement Permit by: RS date 4/30/04
Authorization to Construct by: RS date 11-27-06

Installed by: McCarver Construction
Operation Permit by: RS date 8/9/06
Existing System Inspection by: date

HEALTH DEPT. COPY: WHITE OWNER COPY (FINAL): YELLOW OWNER COPY (INITIAL): PINK