IREDELL COUNTY HEALTH DEPARTMENT

STATESVILLE 704-878-5305 MOORESVILLE 704-664-5281

IMPROVEMENT PERMIT / AUTHORIZATION TO CONSTRUCT / OPERATION PERMIT / EXISTING SYSTEM INSPECTION

PERMIT# 118910 PIN# ~~4644997477.20~~ 4644997208 DATE 4/26/04

OWNER OR CONTRACTOR Burke Builders PHONE: Business 391-0047 Home

ADDRESS PO Box 3481 Mooresville NC 28115

LOCATION 115(S) - TR Bridgesfarm - TR Cloverbank Rd - on RT

SUBDIVISION Estates BLOCK / SECTION LOT 20 LOT AREA .58Ac SITE CLASS. PS DESIGN FLOW 360GPD L.T.A.R. .36GPD/FT2

Septic Tank: 1000 Gallons; STB 317 Date 4/10/06
Pump Tank: 1000 Gallons; PT 27 Date 4/19/06
Pump Make: Model Serial No.
Nitrification Field: No Fields 1 Square Feet 400 Linear Feet 200
No Lines 3 Trench Width 24" Max Trench Bottom Depth 36" Gravel Depth N/A

☑ New System ☐ Repair System Type: I, II, III, IV, V, VI
System Description: LP PANEL
Repair System Description: SAME
Maintenance Agreement Required: ☑ Yes ☐ No

☑ House/Mod. Home No. Bedrooms 3
☐ Mobile Home No. Bathrooms 3
☐ Business No. Employees
☐ Other
☐ Slab ☐ Crawl Space ☐ Basement w/plumbing ☐ Basement wo/plumbing


Water Supply: ☑ Individual ☐ Public ☐ Community

Comments/Conditions: 1) DO NOT CUT HOUSE PAD 2) SITE VISIT REQUIRED BEFORE A/C TO BE ISSUED 3) CHECK FOR EROSION CONTROL METHODS. 4) DO NOT COMPROMISE SEPTIC & REPAIR AREA WITH

Comments/Conditions: → EROSION CONTROL METHODS 5) ROAD NOT CUT AT TIME OF EVALUATION

44 panels 5132" holes

INITIAL SITE SKETCH

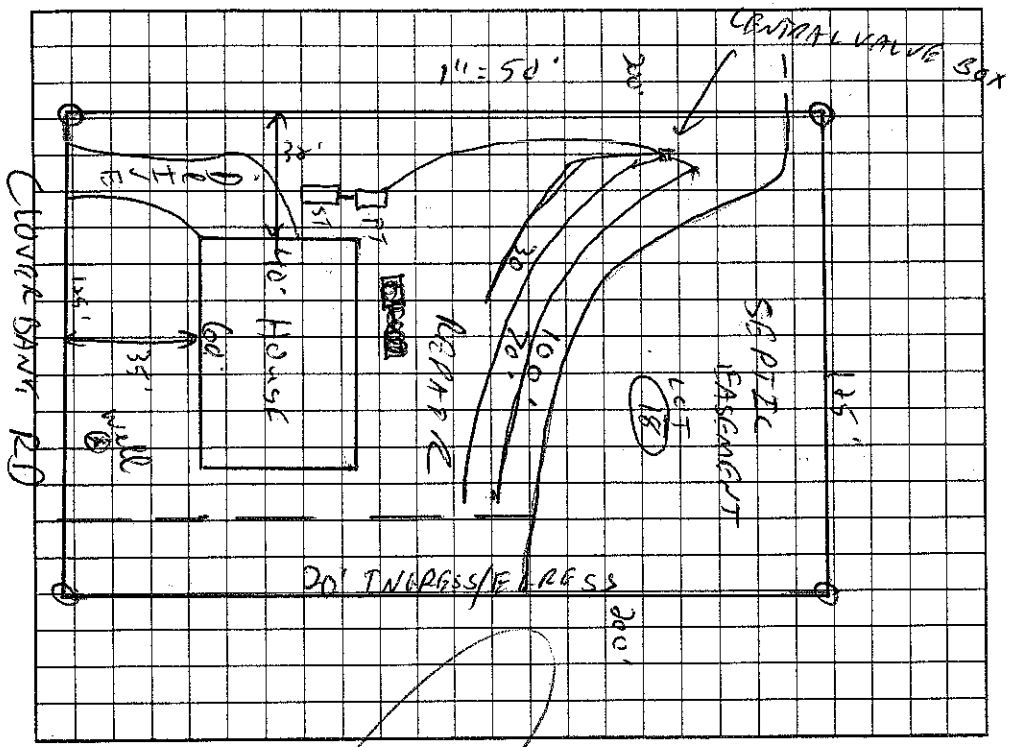

AS BUILT SKETCH

Permit can be suspended or revoked if any false information is supplied toward securing the permit/any unauthorized changes are made to the site/any unauthorized changes are made in the installation of the system. Improvement Permit with plat valid without expiration. Improvement Permit with site plan valid for sixty months. Authorization to Construct is valid for a period equal to that of Improvement Permit – not to exceed sixty months.

Signed: date 4/27/04 Installed by: Bob McCarver

Improvement Permit by: NS date 4/26/04 Operation Permit by: RS date 5/9/06

Authorization to Construct by: RS date 11/15/05 Existing System Inspection by: date

HEALTH DEPT. COPY: WHITE OWNER COPY (FINAL): YELLOW OWNER COPY (INITIAL): PINK