IREDELL COUNTY HEALTH DEPARTMENT

STATESVILLE 704-878-5305 MOORESVILLE 704-664-5281

IMPROVEMENT PERMIT / AUTHORIZATION TO CONSTRUCT / OPERATION PERMIT / EXISTING SYSTEM INSPECTION

PERMIT# 18872 PIN# ~~4644 99 7447.3~~ 4644998016 DATE 4/23/04

OWNER OR CONTRACTOR BURKE BUILDERS PHONE: Business 361-0047 Home

ADDRESS PO BOX 3481 MOORESVILLE NC 28117

LOCATION 115(S) - TR BREEDS FARM - TR CLOVER BANK - LOT ON LT - SEPTIC ON RT

SUBDIVISION THE ESTATES BLOCK / SECTION LOT 3 LOT AREA .55 AC SITE CLASS. ES DESIGN FLOW 360GPD L.T.A.R. .36/.52

Septic Tank: 1000 Gallons; STB 794 Date 1/10/06
Pump Tank: 1000 Gallons; PT 27 Date 1/12/06
Pump Make: Zoeller Model WE07/ZH Serial No.
Nitrification Field: No Fields 1 Square Feet 400 Linear Feet 200
No Lines 4 @ 50' Trench Width 24" Max Trench Bottom Depth 30" Gravel Depth N/A

☑ New System ☐ Repair System Type: I, II, III, IV, V, VI
System Description: ~~TRAD~~ LP RANE C/OFFSITE
Repair System Description: LP RANE C/OFFSITE
Maintenance Agreement Required: ☐ Yes ☑ No


☑ House/Mod. Home No. Bedrooms 3
☐ Mobile Home No. Bathrooms 3
☐ Business No. Employees
☐ Other
☐ Slab ☑ Crawl Space ☐ Basement w/plumbing ☐ Basement wo/plumbing

Water Supply: ☑ Individual ☐ Public ☐ Community

Comments:/Conditions: SEE PLAT FOR SUPPLY LINE ROUTE.
* - ROAD NOT CUT IN AT TIME OF EVALUATION - IF FRONT OF EASEMENT IS DISTURBED PERMIT WILL BE VOIDED. ~~**~~ EROSION CONTROL NOT ESTABLISHED


INITIAL SITE SKETCH

* SITE VEST B-4 AC ISSUED. ** 1"=50'

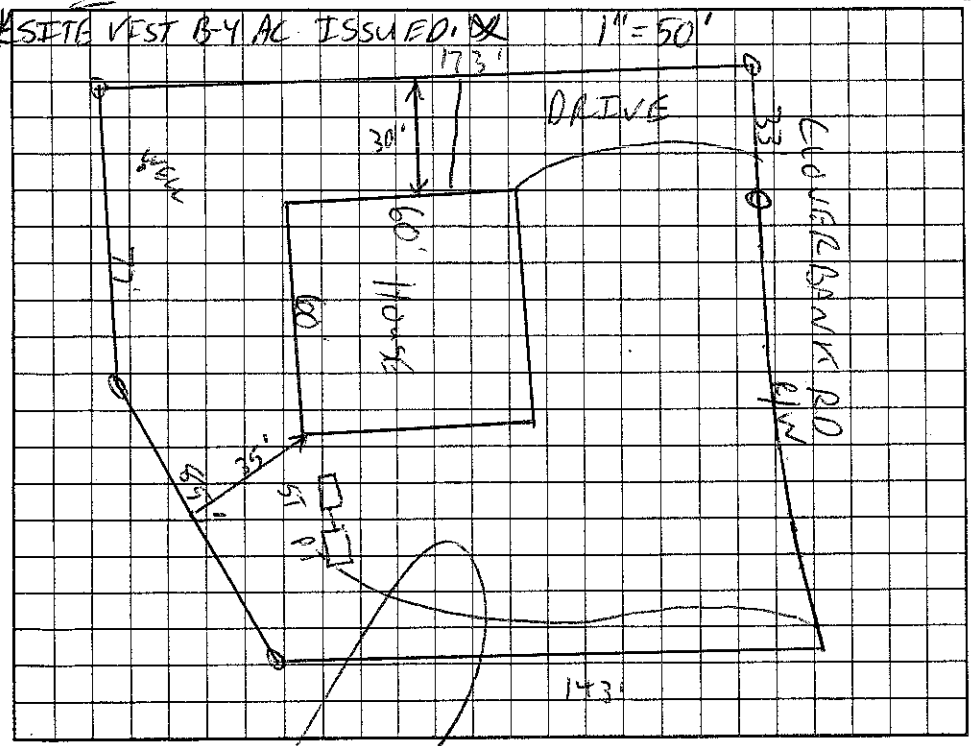

Comments:/Conditions: Central Valve Box

AS BUILT SKETCH 1"=50'

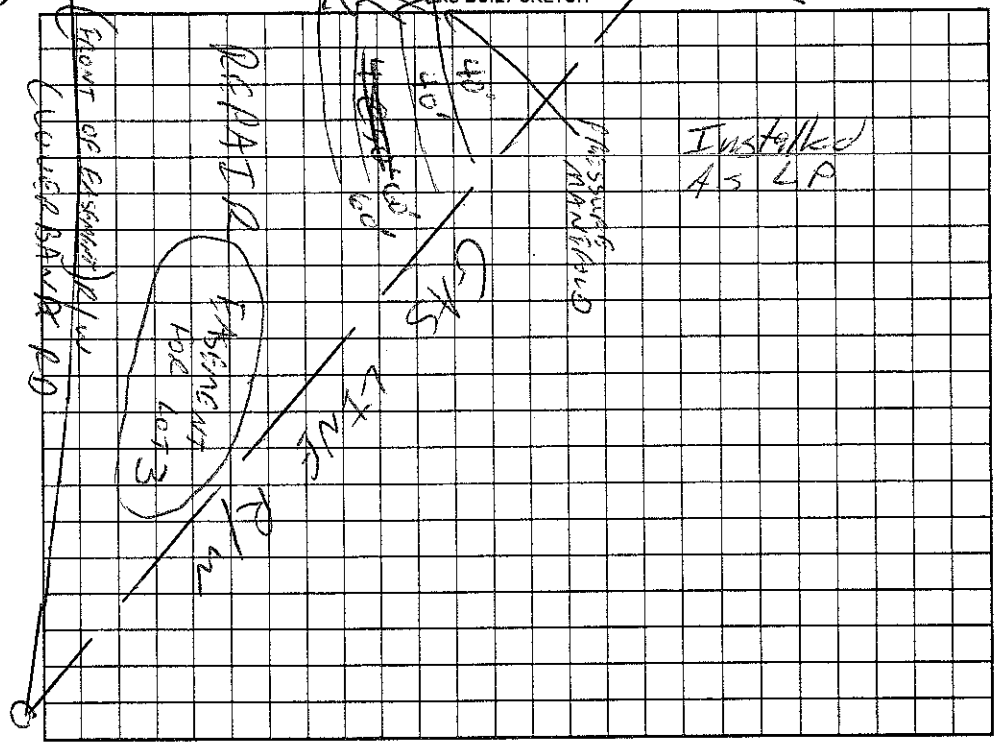

Permit can be suspended or revoked if any false information is supplied toward securing the permit/any unauthorized changes are made to the site/any unauthorized changes are made in the installation of the system. Improvement Permit with plat valid without expiration. Improvement Permit with site plan valid for sixty months. Authorization to Construct is valid for a period equal to that of Improvement Permit – not to exceed sixty months.

Signed: date 4/27/04
Improvement Permit by: RS date 4/23/04
Authorization to Construct by: RS date 10/10/05

Installed by: McCarver
Operation Permit by: RS date 3/30/06
Existing System Inspection by: date

HEALTH DEPT. COPY: WHITE OWNER COPY (FINAL): YELLOW OWNER COPY (INITIAL): PINK