IREDELL COUNTY HEALTH DEPARTMENT

Statesville Phone TR 3-7271 Mooresville Phone NO 3-1271

PERMIT TO INSTALL SEPTIC TANK

Permit NO. _____ Permit Date June 11 1963

Owner Davidson College Address Davidson, N.C.

Installed By Bradford Bros. Address Huntersville, N.C.


Location of Property Davidson College Property on Forks Rimmer--

Tank		Capacity		Length of Lines		Fixtures	
Block	( )	800	( )	150'	( )	No. of Baths	( )
Precast	(X)	900	( )	175'	( )	Dishwasher	( )
		1000	(X)	200'	( )	Garbage Grdr.	( )
		1100	( )	225'	(X)	Auto-Washer	( )
		1200	( )	250'	( )	Other	
		Other		Other			

NOTIFY HEALTH DEPARTMENT AT LEAST EIGHT HOURS BEFORE TANK IS TO BE INSPECTED.

Final Inspection June 11 1963 Approved (X) Disapproved ( )

Remarks _____

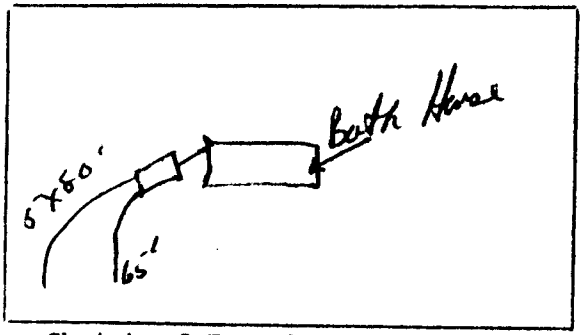

Sketch of Installation

Fay R. Scoggins

Sanitarian