IREDELL COUNTY HEALTH DEPARTMENT

Statesville Phone TR 3-7271 Mooresville Phone NO 3-1271

PERMIT TO INSTALL SEPTIC TANK

Permit NO. _____ Permit Date May 15 1963

Owner Dawkson College Address Davidson N.C.

Installed By Bradford Bros Address Huntersville NC


Location of Property Davidson College Caretaker House on Lake Norman.

Tank		Capacity		Length of Lines		Fixtures	
Block	( )	800	( )	150'	( )	No. of Baths	( )
Precast	(Y)	900	( )	175'	( )	Dishwasher	( )
		1000	(Y)	200'	( )	Garbage Grdr.	( )
		1100	( )	225'	(Y)	Auto-Washer	( )
		1200	( )	250'	( )	Other	
		Other		Other			

NOTIFY HEALTH DEPARTMENT AT LEAST EIGHT HOURS BEFORE TANK IS TO BE INSPECTED.

Final Inspection May 15 1963 Approved (Y) Disapproved ( )

Remarks _____

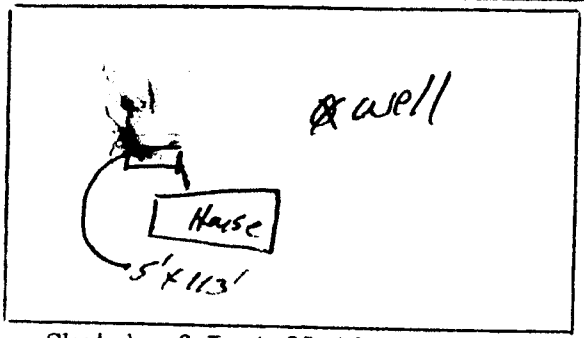

Sketch of Installation

Hoyt R. Swaggerty R.S.

Sanitarian