IREDELL COUNTY HEALTH DEPARTMENT

Statesville Phone TR 3-7271 — Mooresville Phone NO 3-1271

PERMIT TO INSTALL SEPTIC TANK

Permit NO. _____ Permit Date MAY 15 1963

Owner Davidson College Address Davidson N.C.

Installed By Bradford Bros Address Huntersville NC


Location of Property Davidson College Caretaker House on Lake Norman-

Tank		Capacity		Length of Lines		Fixtures	
Block	( )	800	( )	150'	( )	No. of Baths	( )
Precast	(Y)	900	( )	175'	( )	Dishwasher	( )
		1000	(Y)	200'	( )	Garbage Grdr.	( )
		1100	( )	225'	(X)	Auto-Washer	( )
		1200	( )	250'	( )	Other	
		Other		Other			

NOTIFY HEALTH DEPARTMENT AT LEAST EIGHT HOURS BEFORE TANK IS TO BE INSPECTED.


Final Inspection MAY 15 1963 Approved (Y) Disapproved ( )

Remarks _____

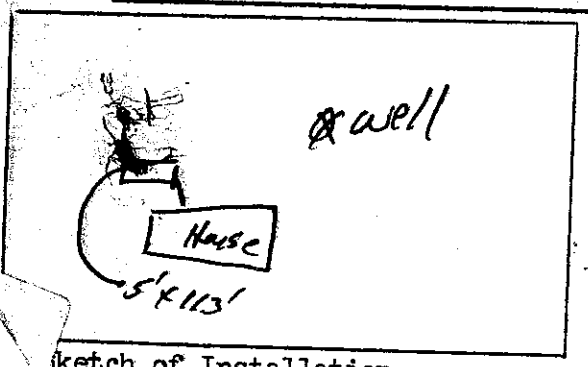

Sketch of Installation

Hoyt R. Sprouse R-S
Sanitarian

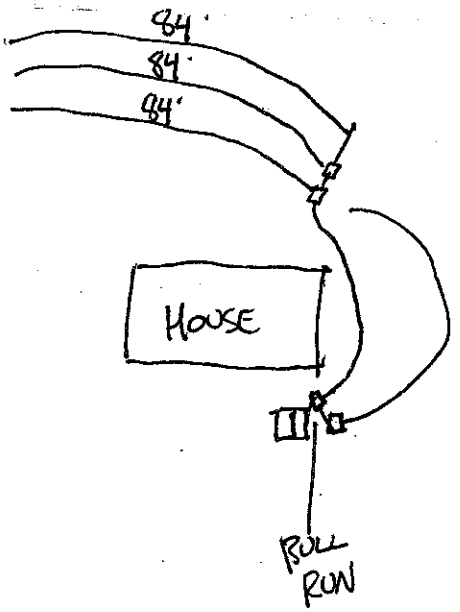

3 LINES @ 84'

BULL RUN VALVE

USE OLD TANK