IREDELL COUNTY HEALTH DEPARTMENT

STATESVILLE 704-878-5305 MOORESVILLE 704-664-5281

IMPROVEMENT PERMIT / AUTHORIZATION TO CONSTRUCT / OPERATION PERMIT / EXISTING SYSTEM INSPECTION

PERMIT# 121932 PIN# 4645 06 7440.000 DATE 4/16/05

OWNER OR CONTRACTOR Kathryn Mabry PHONE: Business 704-663-6034 Home

ADDRESS 160 Chandelora Dr. Mooresville, NC 28117

LOCATION Cove R Tarpleton L Corino Real L thru Gate, 2nd on R

SUBDIVISION Cove BLOCK / SECTION LOT 7 LOT AREA 3.31 SITE CLASS. P3 DESIGN FLOW 480 L.T.A.R. c 3

Septic Tank: ~~1000~~ 1500 Gallons; STB 338 Date 12-9-05

Pump Tank: Gallons; PT Date

Pump Make: Model Serial No.

Nitrification Field: No Fields 1 Square Feet 1200 Linear Feet ~~500~~ 480

No Lines ~~5~~ 4 @ 105 Trench Width 3 Max Trench Bottom Depth 3 Gravel Depth No

☒ New System ☐ Repair System Type: I, II, III, IV, V, VI

System Description: 25% Reduced

Repair System Description: None

Maintenance Agreement Required: ☐ Yes ☐ No

☒ House/Mod. Home No. Bedrooms ~~3~~ 4

☐ Mobile Home No. Bathrooms 3.5

☐ Business No. Employees

☐ Other

☐ Slab ☐ Crawl Space ☐ Basement w/plumbing ☐ Basement wo/plumbing


Water Supply: ☒ Individual ☐ Public ☐ Community

Comments:/Conditions:


Comments:/Conditions:

1" = 40'

INITIAL SITE SKETCH

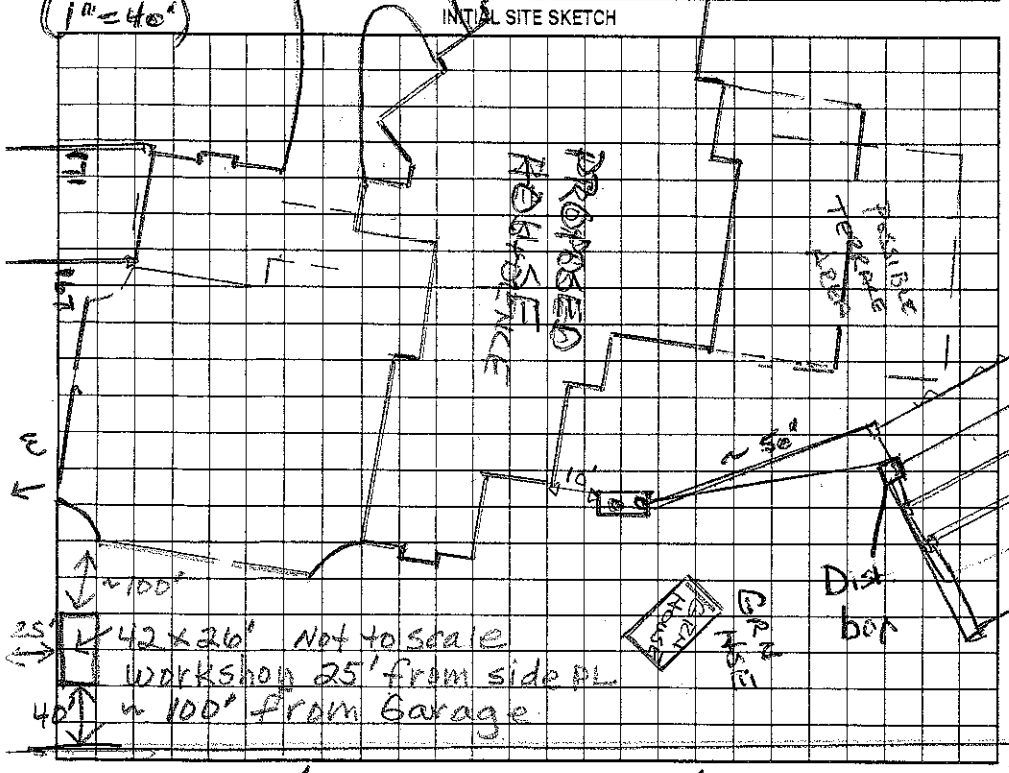

AS BUILT SKETCH

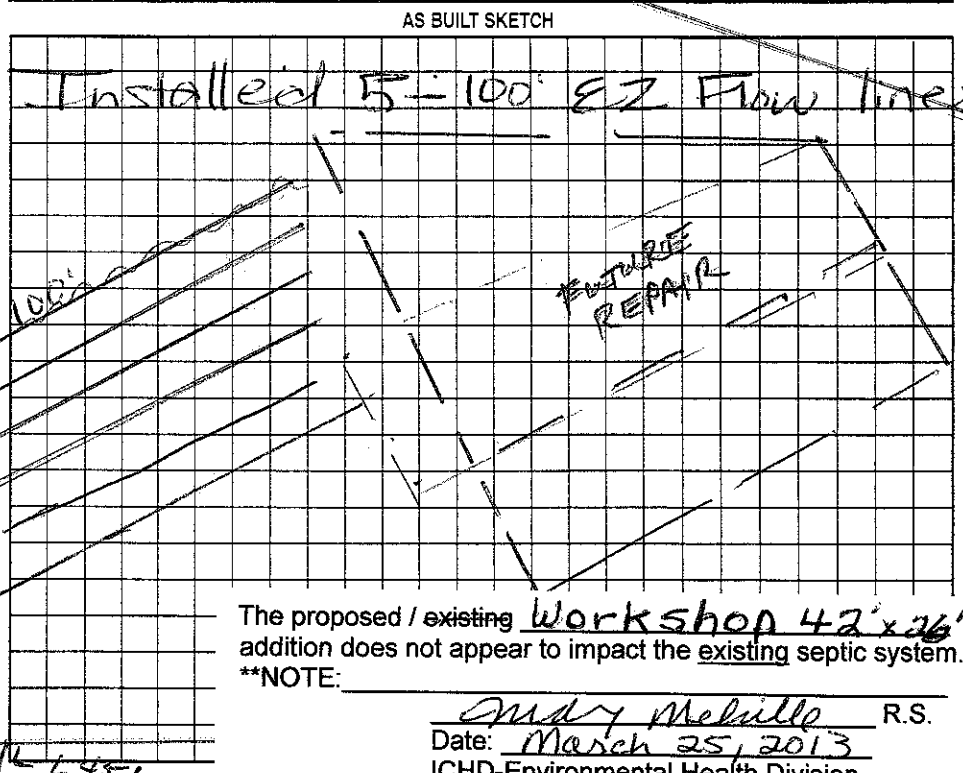

The proposed / ~~existing~~ Workshop 42'x26' addition does not appear to impact the existing septic system.

**NOTE:

Andy Melville R.S.

Date: March 25, 2013

ICHD-Environmental Health Division

Permit can be suspended or revoked if any false information is supplied toward securing the permit/any unauthorized changes are made to the site/any unauthorized changes are made in the installation of the system. Improvement Permit with plat valid without expiration. Improvement Permit with site plan valid for sixty months. Authorization to Construct is valid for a period equal to that of Improvement Permit – not to exceed sixty months.

Signed: John C. McDowell date 4-18-05

Improvement Permit by: Wesley Sparks RS date 4/16/05

Authorization to Construct by: Wesley Sparks RS date 4/16/05

Installed by: R&H

Operation Permit by: Maria Hill Dotson RS date 2/14/06

Existing System Inspection by: date

HEALTH DEPT. COPY: WHITE OWNER COPY (FINAL): YELLOW OWNER COPY (INITIAL): PINK