4645076238 4

IREDELL COUNTY HEALTH DEPARTMENT

Authorization to Construct

STATESVILLE 704-878-5305 MOORESVILLE 704-664-5281

IMPROVEMENT PERMIT / ~~CERTIFICATE OF COMPLETION~~ / OPERATION PERMIT / EXISTING SYSTEM INSPECTION

PROPERTY DESCRIPTION NO. 25302 DATE 1/6/97 TAX MAP NO. 2G A 8A Watershed: [X] Yes [ ] No

OWNER OR CONTRACTOR Calvin Murray McConnell PHONE: Business _____ Home 892-8983

ADDRESS 1993 Oak Leaf Cr. Cornelius, NC. 28031

LOCATION Templeton TL Combs Rd ~ 2 mile TR to lake house on (L)

SUBDIVISION _____ BLOCK / SECTION _____ LOT _____ LOT AREA _____ SITE CLASS. PS DESIGN FLOW 480 L.T.A.R. .3

Septic Tank: 1000 Gallons; STB 794 Date 3/13/98

Pump Tank: _____ Gallons; PT _____ Date _____

Pump Make: _____ Model _____ Serial No. _____

Nitrification Field: No Fields 2 Square Feet 1600 Linear Feet 536

No Lines 3+3 Trench Width 36" Max Trench Bottom Depth 32" Gravel Depth 12"

[X] New System [ ] Repair System Type: I, II, (III) IV, V, VI

System Description: FLOWDIVIDER—CONVENTIONAL

Repair System Description: CH PLASTIC

Maintenance Agreement Required: [ ] Yes [X] No

[X] House/Mod. Home [ ] Mobile Home [ ] Business [ ] Other

No. Bedrooms 4 No. Bathrooms 3.5 No. Employees _____


[ ] Slab [X] Crawl Space [ ] Basement w/plumbing [ ] Basement wo/plumbing

Water Supply: [X] Individual [ ] Community [ ] Public


Comments:

Comments:

INITIAL SITE SKETCH

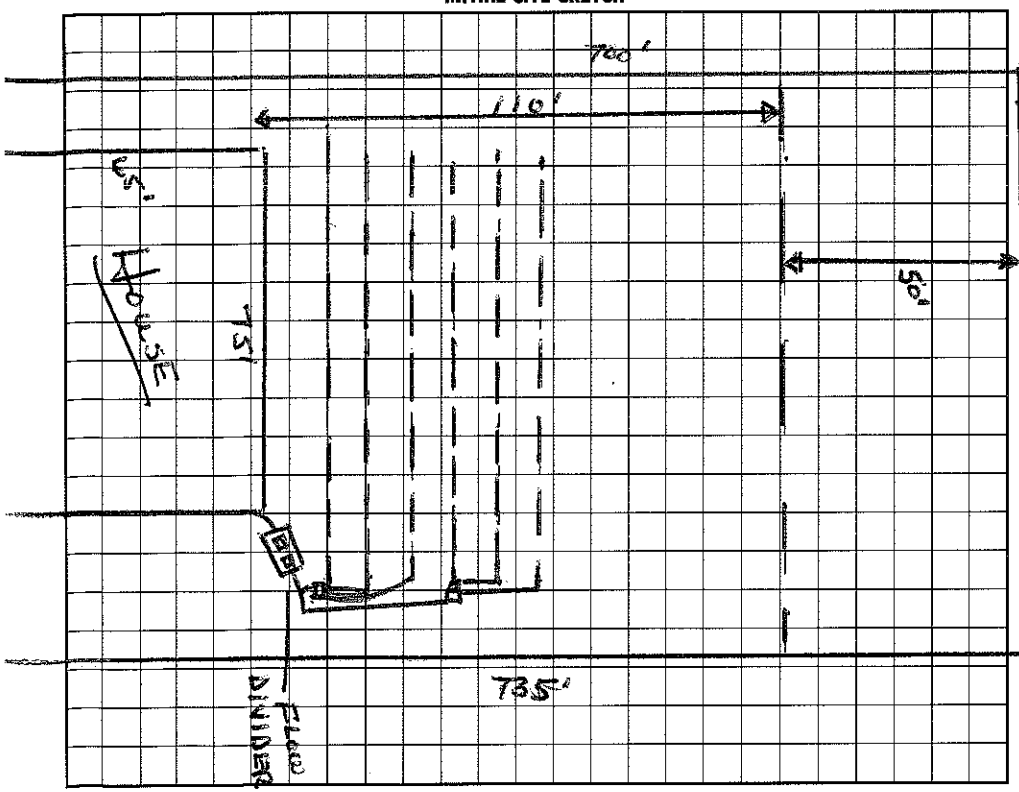

AS BUILT SKETCH

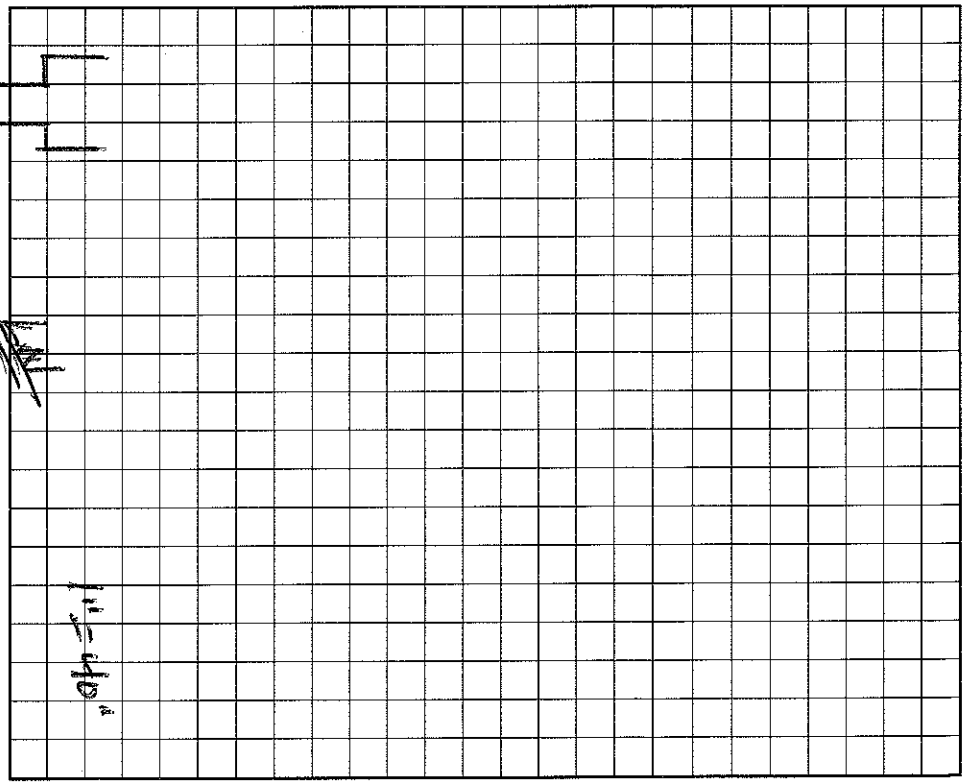

I understand that this permit can be suspended or revoked if any false information is supplied toward securing the permit/any unauthorized changes are made to the site/any unauthorized changes are made in the installation of the system.

Signed: Stephen M. McConnell

Improvement Permit by: Wesley Sparks RS. date 1/6/97

~~Existing System Inspection by:~~ Wesley Sparks RS. date 1/6/97

Installed by: MAYHEW

Certificate of Completion by: _____ date _____

Operation Permit by: _____ date 5/15/98

HEALTH DEPT. COPY: WHITE INSPECTION COPY (FINAL): GREEN OWNER COPY (FINAL): YELLOW INSPECTION COPY (INITIAL): PINK OWNER COPY (INITIAL): GOLD