4645076234

IREDELL COUNTY HEALTH DEPARTMENT

Authorization to Construct

210

STATESVILLE 704-878-5305 MOORESVILLE 704-664-5281

IMPROVEMENT PERMIT / CERTIFICATE OF COMPLETION / OPERATION PERMIT / EXISTING SYSTEM INSPECTION

PROPERTY DESCRIPTION NO. 25303 DATE 1/6/97 TAX MAP NO. 2G A 2A56

OWNER OR CONTRACTOR Calvin Massey McConnell PHONE: Business Home 892-8983 Watershed: [X] Yes [ ] No

ADDRESS 1993 Oak Leaf Cir. Connelly Springs, NC 28631

LOCATION Templeton Rd to Camino Real Rd. ± .2 mile on (R)

SUBDIVISION BLOCK / SECTION LOT LOT AREA SITE CLASS. PS DESIGN FLOW 360 L.T.A.R. .3

Septic Tank: 1000 Gallons; STB 794 Date 3/20/98

Pump Tank: Gallons; PT Date

Pump Make: Model Serial No.

Nitrification Field: No Fields 1 Square Feet 1200 Linear Feet 400

No Lines 16 Trench Width 36" Max Trench Bottom Depth 36" Gravel Depth 12"

[X] New System [ ] Repair System Type: I, (II), III, IV, V, VI

System Description: GRAV - CONVENTIONAL

Repair System Description: SAME

Maintenance Agreement Required: [ ] Yes [X] No

[X] House/Mod. Home [ ] Mobile Home [ ] Business [ ] Other

No. Bedrooms 3 No. Bathrooms 3.5 No. Employees


[ ] Slab [X] Crawl Space [ ] Basement w/plumbing [ ] Basement wo/plumbing

Water Supply: [X] Individual [ ] Community [ ] Public


Comments:

Comments:

INITIAL SITE SKETCH

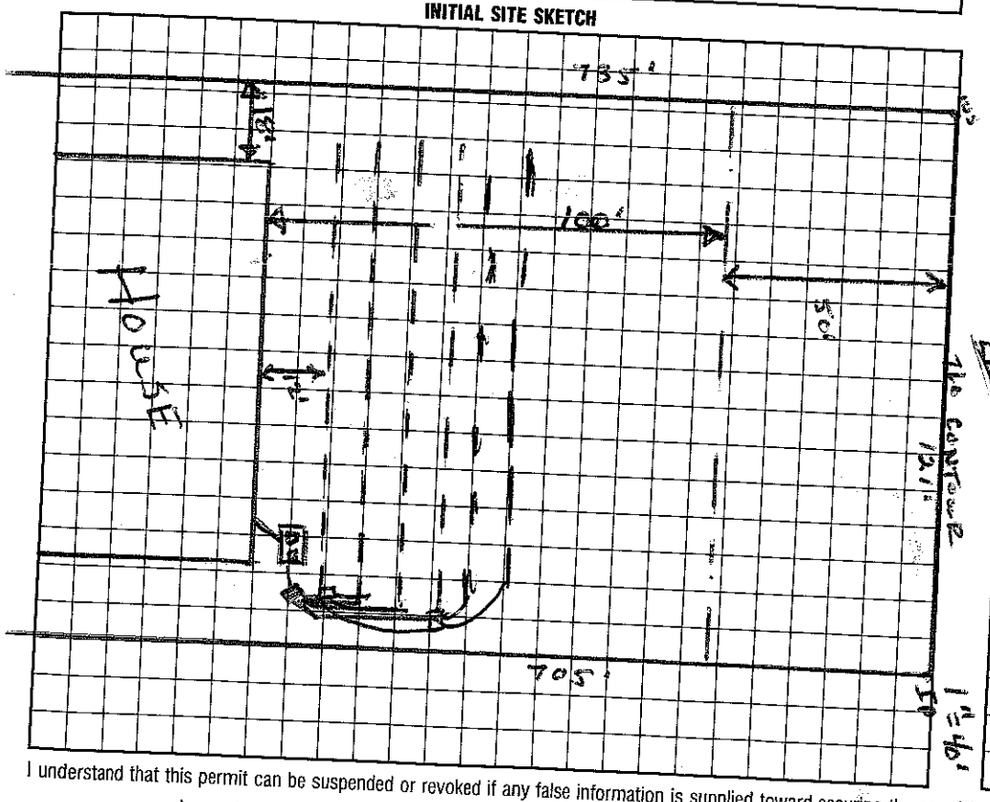

AS BUILT SKETCH

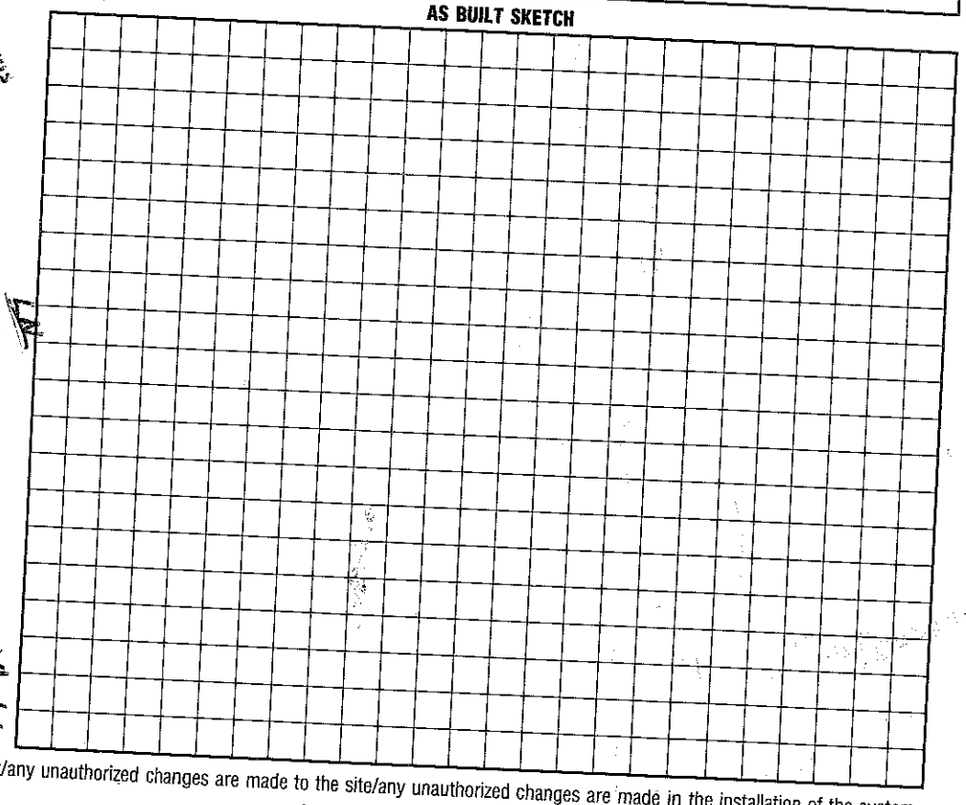

I understand that this permit can be suspended or revoked if any false information is supplied toward securing the permit/any unauthorized changes are made to the site/any unauthorized changes are made in the installation of the system.

Signed: Stephen M. McConnell

Improvement Permit by: Wesley Sparks RS. date 1/6/97

~~Existing System Inspection by:~~ Wesley Sparks RS. date 1/6/97

Installed by: MATHEW

Certificate of Completion by: date

Operation Permit by: RS date 5/29/98

HEALTH DEPT. COPY: WHITE INSPECTION COPY (FINAL): GREEN OWNER COPY (FINAL): YELLOW INSPECTION COPY (INITIAL): PINK OWNER COPY (INITIAL): GOLD