# IREDELL COUNTY HEALTH DEPARTMENT

STATESVILLE 704-878-5305 Paid 200.00 CK 1100 MOORESVILLE 704-664-5281

## IMPROVEMENT PERMIT / AUTHORIZATION TO CONSTRUCT / OPERATION PERMIT / EXISTING SYSTEM INSPECTION

PERMIT# 079680 PIN# ~~4645068612~~ ~~4645-07-7939~~ 4645-07-7939 DATE Nov. 3, 00

OWNER OR CONTRACTOR KAREN Schroeder PHONE: Business 662-0339 Home

ADDRESS 123 Chaucer Ln. Mooresville, N.C. 28117

LOCATION Alcove Rd TR Templeton on left NEAR end across from Irish Rd.

SUBDIVISION Green Investments BLOCK / SECTION LOT 2 LOT AREA 25,000 ft² ± SITE CLASS. PS DESIGN FLOW 360 gpd L.T.A.R. .3

Septic Tank: 1000 Gallons; STB 794 Date 6-17-02
Pump Tank: 1000 Gallons; PT 283 Date 7-30-02
Pump Make: Meyers Model ME3F Serial No.
Nitrification Field: No Fields 1 Square Feet 600 Linear Feet 200
No Lines 4@F6 Trench Width 36" Max Trench Bottom Depth 36" Gravel Depth NA

☑ New System ☐ Repair System Type: I, II, III, IV, V, VI
System Description: LP Panel Block
Repair System Description: SAME
Maintenance Agreement Required: ☑ Yes ☐ No

~~☐~~ House/Mod. Home No. Bedrooms 3
☐ Mobile Home No. Bathrooms 3.5
☐ Business No. Employees
☐ Other
☑ Slab ☑ Crawl Space ☐ Basement w/plumbing ☐ Basement wo/plumbing


Water Supply: ☑ Individual ☐ Public ☐ Community

Comments:/Conditions: INSTALL WELL EXACTLY WHERE SHOWN.

Comments:/Conditions: Reviewed Building plans 4/24/2002; in compliance with permit MD
5/32" hole drilled
11 panels per ditch


1" = 40'

INITIAL SITE SKETCH

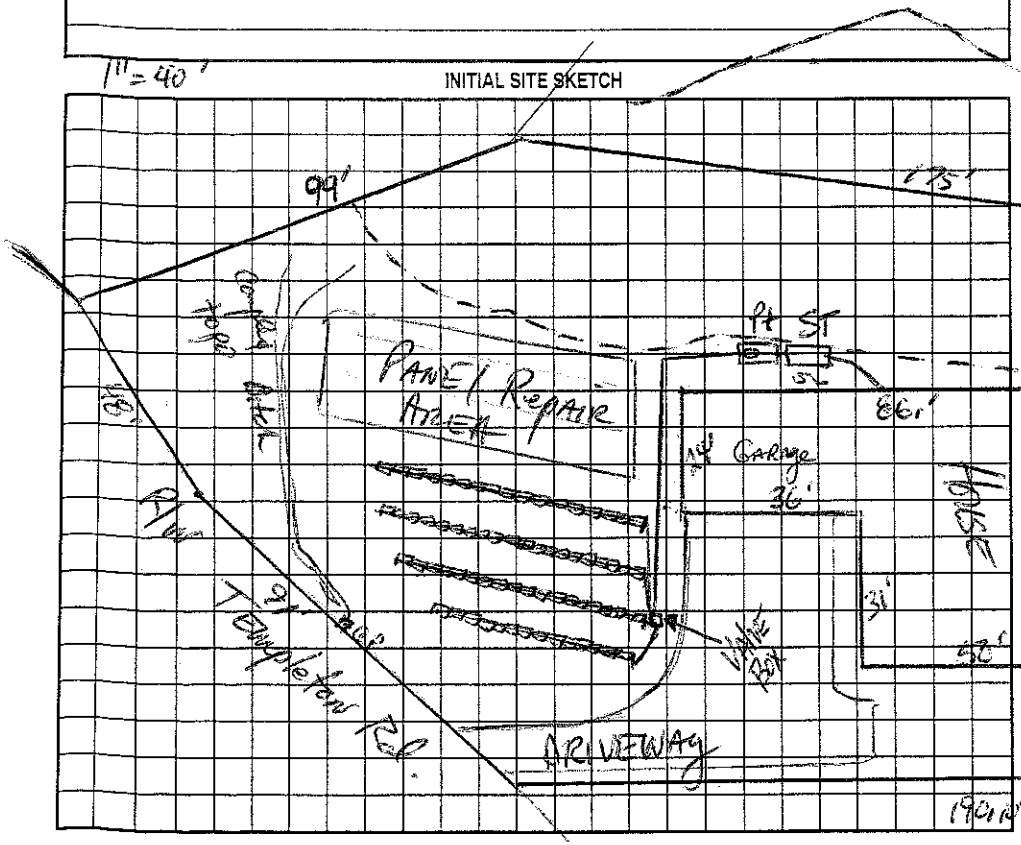


AS BUILT SKETCH

Checked tanks & lines 9/10/02
Pres, elect & alarm 10/7/02

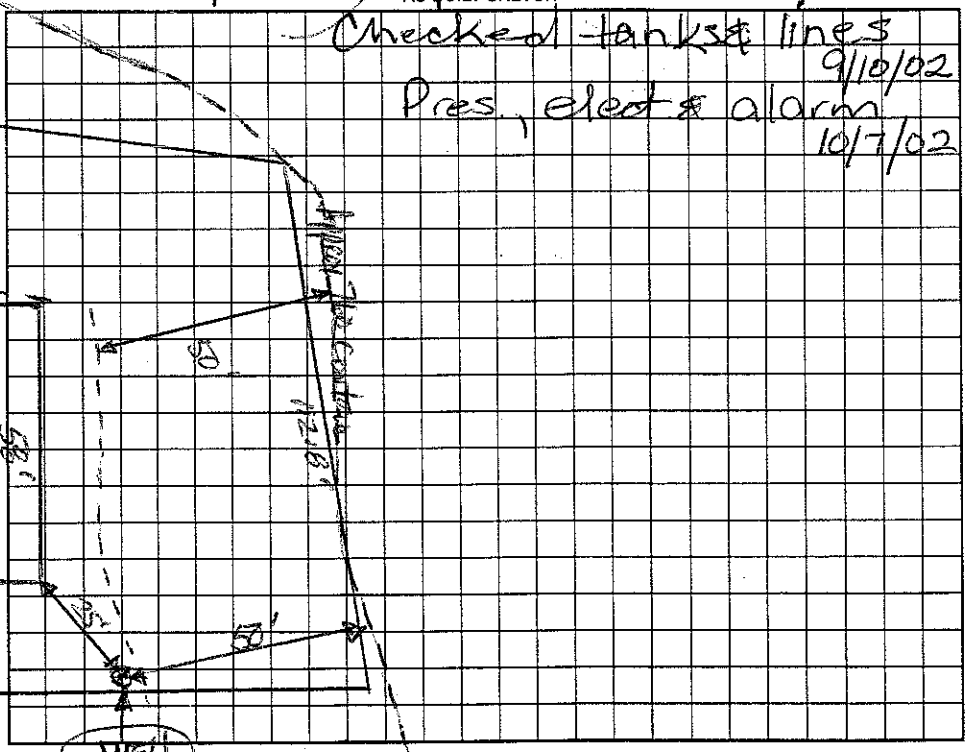


Permit can be suspended or revoked if any false information is supplied toward securing the permit/any unauthorized changes are made to the site/any unauthorized changes are made in the installation of the system. Improvement Permit with plat valid without expiration. Improvement Permit with site plan valid for sixty months. Authorization to Construct is valid for a period equal to that of Improvement Permit – not to exceed sixty months.

Signed: A. Randy Henderson date Nov. 3, 2000 Installed by: R & H Inc

Improvement Permit by: Maria H. Nelson RS date Nov. 3, 00 Operation Permit by: Maria H. Nelson RS date 10/9/02

Authorization to Construct by: Maria H. Nelson RS date 4/24/2002 Existing System Inspection by: date

HEALTH DEPT. COPY: WHITE OWNER COPY (FINAL): YELLOW OWNER COPY (INITIAL): PINK