IREDELL COUNTY HEALTH DEPARTMENT

STATESVILLE 704-878-5305 $50 MOORESVILLE 704-664-5281

IMPROVEMENT PERMIT / AUTHORIZATION TO CONSTRUCT / OPERATION PERMIT / EXISTING SYSTEM INSPECTION

PERMIT# 117284 PIN# 4645 07 8995 DATE 5/17/04

OWNER OR CONTRACTOR Timothy Waylett PHONE: Business 704-319-4141 Home

ADDRESS 174 Lakeshore Dr. Mooresville, NC. 28117

LOCATION Templeton Rd; W Howsons TR & Reeves TR Templeton (R) at Oak, last lot on (L) before gravel

SUBDIVISION Green Forest BLOCK / SECTION LOT 3 LOT AREA ~ 25,000 Ft² SITE CLASS. PS DESIGN FLOW 360 L.T.A.R. .3

Septic Tank: 1000 Gallons; STB 825 Date 11/3/05
Pump Tank: 1000 Gallons; PT 302 Date 9/18/04
Pump Make: Model Serial No.
Nitrification Field: No Fields 1 Square Feet 400/600 Linear Feet 200-262
No Lines 4 Trench Width 2-3 Max Trench Bottom Depth 3' Gravel Depth No

[X] New System [ ] Repair System Type: I, II, III, (IV), V, VI
System Description: Plus Dosed 16" APBPS
Repair System Description: Some Type
Maintenance Agreement Required: [X] Yes [ ] No


[X] House/Mod. Home No. Bedrooms 3
[ ] Mobile Home No. Bathrooms 3
[ ] Business No. Employees
[ ] Other
[ ] Slab [X] Crawl Space [ ] Basement w/plumbing [ ] Basement wo/plumbing

Water Supply: [X] Individual [ ] Public [ ] Community

Comments:/Conditions: Drainage Improvements must be made before Repair Area can be utilized on front of lot. NO BASEMENT Do not grade down Need to Review Assumptions.

Comments:/Conditions: 4 at 50' x 2' installed

INITIAL SITE SKETCH

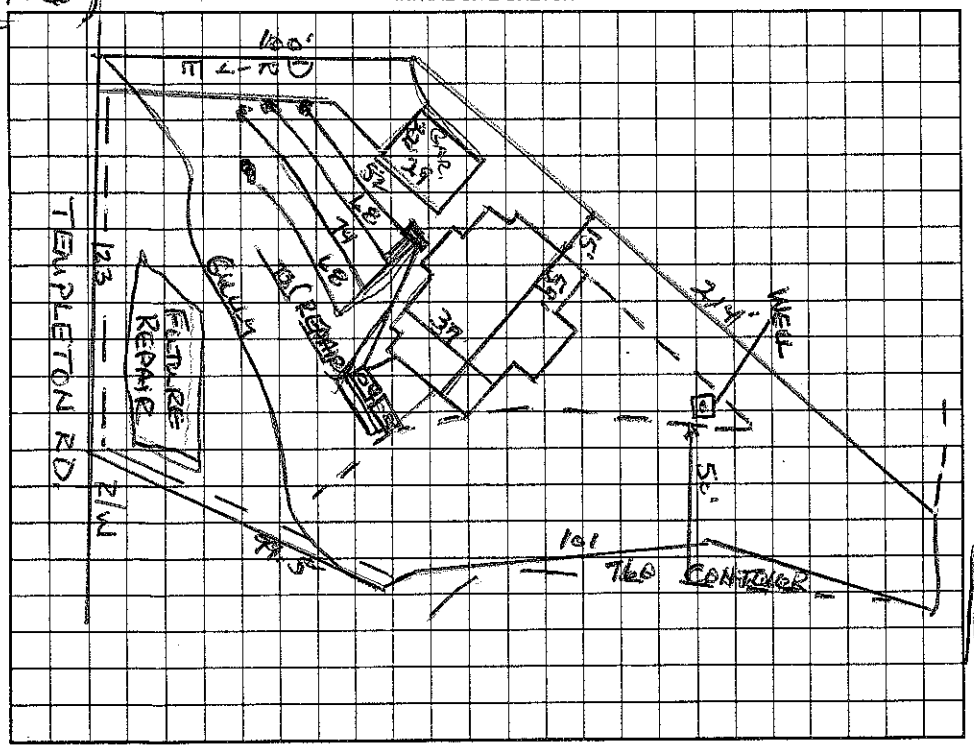

AS BUILT SKETCH

Permit can be suspended or revoked if any false information is supplied toward securing the permit/any unauthorized changes are made to the site/any unauthorized changes are made in the installation of the system. Improvement Permit with plat valid without expiration. Improvement Permit with site plan valid for sixty months. Authorization to Construct is valid for a period equal to that of Improvement Permit – not to exceed sixty months.

Signed: [signature] date 5/21/04
Improvement Permit by: Wesley Sparks R.S. date 5/17/04
Authorization to Construct by: [signature] RS date 5/21/04

Installed by: Rowan Septic Tank
Operation Permit by: Wesley Sparks R.S. date 3/17/05
Existing System Inspection by: date

HEALTH DEPT. COPY: WHITE OWNER COPY (FINAL): YELLOW OWNER COPY (INITIAL): PINK