IREDELL COUNTY HEALTH DEPARTMENT - *ENVIRONMENTAL HEALTH* ☐ STATESVILLE OFFICE 704-878-5305 ☒ MOORESVILLE OFFICE 704-664-528

IMPROVEMENT PERMIT / AUTHORIZATION TO CONSTRUCT / OPERATION PERMIT / EXISTING SYSTEM INSPECTION

PERMIT # 168167 PIN # 4645-08-5062 DATE 8-31-11

OWNER MURRAY CLAYTON APPLICANT: SAME PHONE: Home/Cell # 336-601-2208 Business #

SITE ADDRESS 425 TEMPLETON RD OWNER / APPLICANT ADDRESS SAME

SITE DIRECTIONS ALCOVE, TEMPLETON, ON L

SUBDIVISION GREEN INVESTME BLOCK / SECTION LOT # 1 LOT AREA .59AC DESIGN FLOW 360 L.T.A.R. 3

Septic Tank 1000 Gallons: STB ~~1000~~ 760 Date 5-8-11
Pump Tank Gallons: P T Date
Pump Make Model Serial #
No. Nitrification Fields: 1 No. Lines 5 Linear Feet 300'
Trench Width 36" Max. Trench Bottom Depth 36"

☒ New System ☐ Repair ☐ Expansion System Type I II (III) IV V VI
System Description: 25% REDUCTION
Repair System Description: PRE 1983
Maintenance Agreement Required ☐ YES ☒ NO
Gravel Depth ☒ GRAVITY ☐ PRESSURE


☒ Residence No. Bedrooms 3
☐ Business No. Persons
☐ Other No. Employees
☐ Slab ☒ Crawl Space
☐ Basement w/plumbing ☐ Basement w/o plumbing

Water Supply: ☒ Private ☐ Public ☐ Community

Comments / Conditions ① KNOW 50' SETBACK BEFORE INSTALLATION
② MEET ALL SETBACKS

Installed Quick 4 essentially as drawn

INITIAL SITE SKETCH

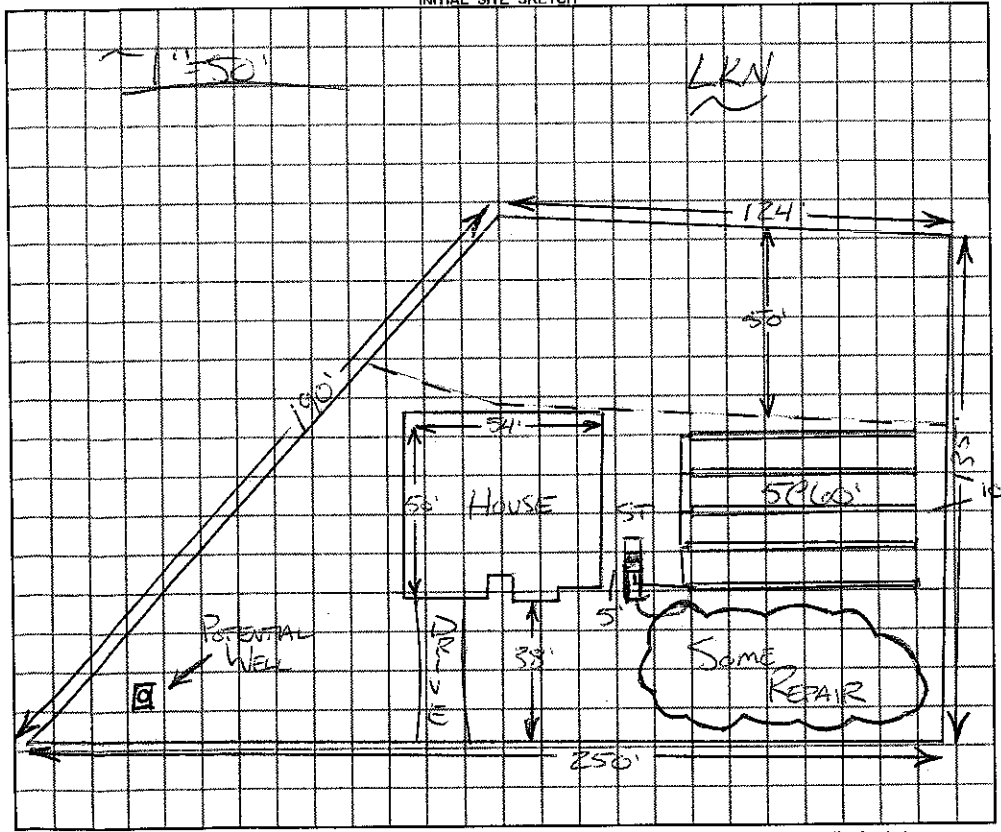

AS BUILT SKETCH

Permit can be suspended or revoked if any false information is supplied toward securing the permit / any unauthorized changes are made to the site / any unauthorized changes are made in the installation of the system.

☐ ***IMPROVEMENT PERMIT*** *with plat valid without expiration.* ☐ ***IMPROVEMENT PERMIT*** *with plat valid without expiration. site plan valid 60 mo.* ☒ ***AUTHORIZATION TO CONSTRUCT*** valid for period equal to IMPROVEMENT PERMIT–not to exceed 60 mo.

Owner / Applicant Signature: Brad Jenkins Schumacher Homes NC Date 9-6-11 Installed by: Specialty Septic Sys

IMPROVEMENT PERMIT by: R.A. REHS Date 8-31-11 OPERATION PERMIT by: REHS Date 10/10/201

AUTHORIZATION TO CONSTRUCT by: R.A. REHS Date 8-31-11 Existing System Inspected by: REHS Date

YOU SHOULD CONTACT A LOCATOR SERVICE PRIOR TO ANY EXCAVATION

White Copy – Environmental Health YELLOW COPY (Final) Owner / Applicant PINK COPY (Initial) Owner / Applicant