# IREDELL COUNTY HEALTH DEPARTMENT

STATESVILLE 704-878-5305 MOORESVILLE 704-664-5281 Copy

## IMPROVEMENT PERMIT / AUTHORIZATION TO CONSTRUCT / OPERATION PERMIT / EXISTING SYSTEM INSPECTION

PERMIT # 1641698 PIN # 4645-08-9712 DATE 1-26-11

OWNER or APPLICANT MICHAEL GALITSIS PHONE: Business 276-613-0630 Home:

OWNER or APPLICANT ADDRESS PO BOX 1355 WYTHEVILLE, VA 24382

LOCATION / DIRECTIONS ALCOVE, TEMPLETON, TR IRISH, 1ST ON R

SUBDIVISION RA WHITE BLOCK / SECTION LOT # 33 LOT AREA .91AC DESIGN FLOW 480 GPD L.T.A.R. .4 (PER PERMIT # 08395)

Septic Tank 1000 Gallons: STB 794 Date 8-15-10
Pump Tank Gallons: P T Date
Pump Make Model Serial #
Nitrification Field No Fields 5 No Lines Linear Feet 6
Trench Width Max. Trench Bottom Depth Gravel Depth

☒ New System ☐ Repair ☐ Expansion System Type I II III IV V VI
System Description: 1000 GAL SEPTIC TANK
Repair System Description: 25% RED
Maintenance Agreement Required ☐ YES ☒ NO
☒ GRAVITY ☐ PRESSURE


☒ Residence No. Bedrooms 4
☐ Business No. Persons
☐ Other No. Employees
☐ Slab ☐ Crawl Space
☒ Basement w/plumbing ☐ Basement w/o plumbing

Water Supply: ☒ Private ☐ Public ☐ Community


Comments / Conditions: (1) DRAIN LINES & UPPER TANK ARE EXISTING (2) INSTALL NEW 1000 GAL TANK (3) PUMP, CRUSH & FILL OLD 440 GAL TANK

Comments / Conditions

INITIAL SITE SKETCH

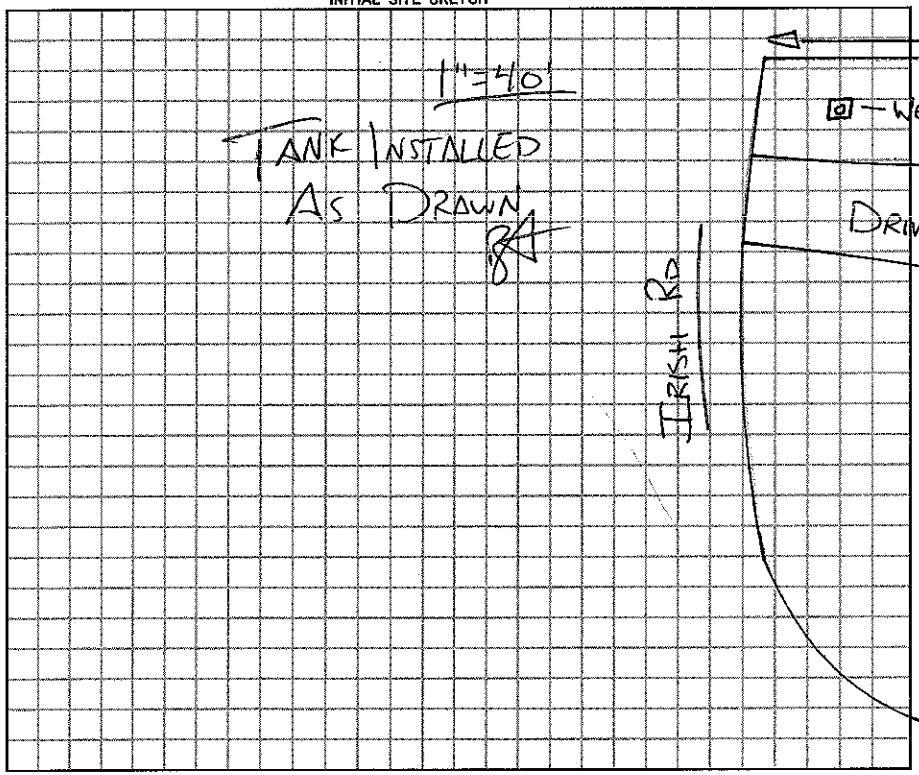


AS BUILT SKETCH

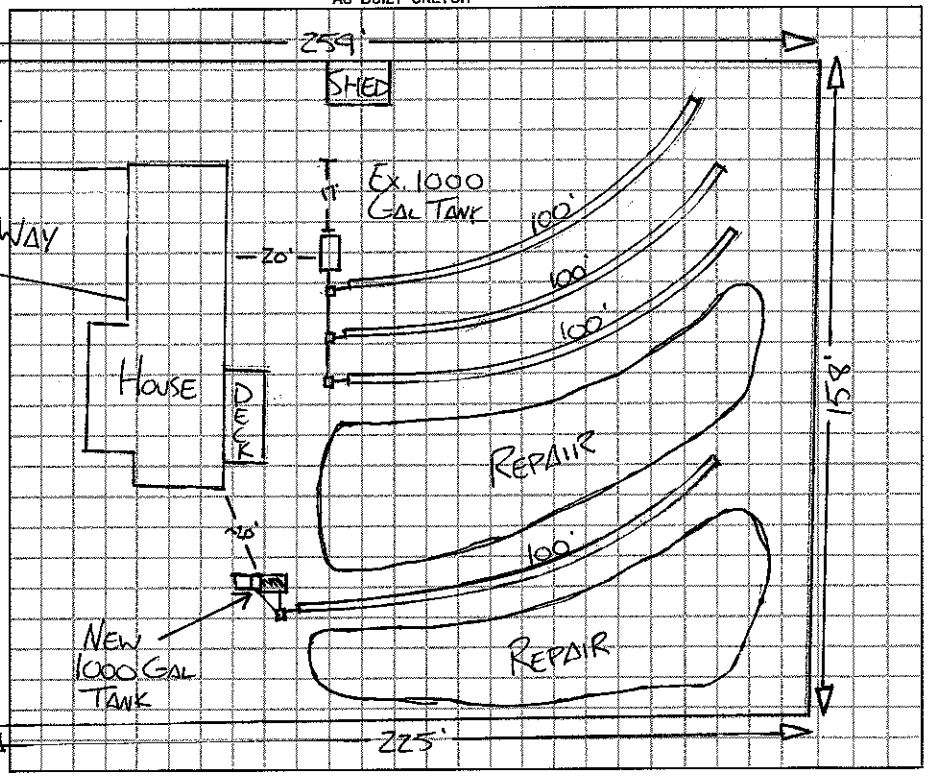


*Permit can be suspended or revoked if any false information is supplied toward securing the permit / any unauthorized changes are made to the site / any unauthorized changes are made in the installation of the system.*

☐ *IMPROVEMENT PERMIT w / plat valid without expiration.* ☐ *IMPROVEMENT PERMIT w / site plan valid for 60 mos.* ☐ *AUTHORIZATION TO CONSTRUCT valid for period equal to IMPROVEMENT PERMIT-not to exceed 60 mo.*

Owner / Applicant Signature: Mike Galitsis By Rich Upgan Date 1-27-11

Improvement Permit by: REHS Date 1-26-11

Authorization to Construct by: REHS Date 1-26-11

**YOU SHOULD CONTACT A LOCATOR SERVICE PRIOR TO ANY EXCAVATION.**

Installed by: STEVE JORDAN

Operation Permit by: REHS Date: 2-1-11

Existing System Inspected by: Date:

WHITE COPY Environmental Health YELLOW COPY (Final) Owner / Applicant PINK COPY (Initial) Owner / Applicant