IREDELL COUNTY HEALTH DEPARTMENT

STATESVILLE 704-878-5305 125.00 Paid MOORESVILLE 704-664-5281

IMPROVEMENT PERMIT / AUTHORIZATION TO CONSTRUCT / OPERATION PERMIT / EXISTING SYSTEM INSPECTION

PERMIT# 103219 PIN# 4645 08 9669 DATE 11/13/01

OWNER OR CONTRACTOR Michael & Heba Brown PHONE: Business Shaw - 902-0085 Home

ADDRESS 139 Christ Rd. Mooresville, NC. 28117

LOCATION Wellman Rd. TR Alcon Rd. R onto Templeton (R) fork around curve on (R) at Bob white

SUBDIVISION RA White BLOCK / SECTION LOT 30 LOT AREA ~.8Ac SITE CLASS. PS DESIGN FLOW 360 L.T.A.R. .3

Septic Tank: 1000 Gallons; STB 1007 Date 2/20/02
Pump Tank: Gallons; PT Date
Pump Make: Model Serial No.
Nitrification Field: No Fields 1 Square Feet * 900 Linear Feet * 300
No Lines * 4@75' Trench Width 3' Max Trench Bottom Depth 3' Gravel Depth No

[X] New System [ ] Repair System Type: I, II, [III] IV, V, VI
System Description: GRAV - EZ FLOW ORCH, PLASTK
Repair System Description: Pressure to Type 3
Maintenance Agreement Required: [ ] Yes [X] No


[X] House/Mod. Home No. Bedrooms 3
[ ] Mobile Home No. Bathrooms 3
[ ] Business No. Employees
[ ] Other
[ ] Slab [X] Crawl Space [ ] Basement w/plumbing [ ] Basement wo/plumbing

Water Supply: [X] Individual [ ] Public [ ] Community

Comments:/Conditions: * 25% Reduced System

Comments:/Conditions:

INITIAL SITE SKETCH (1" = 50')

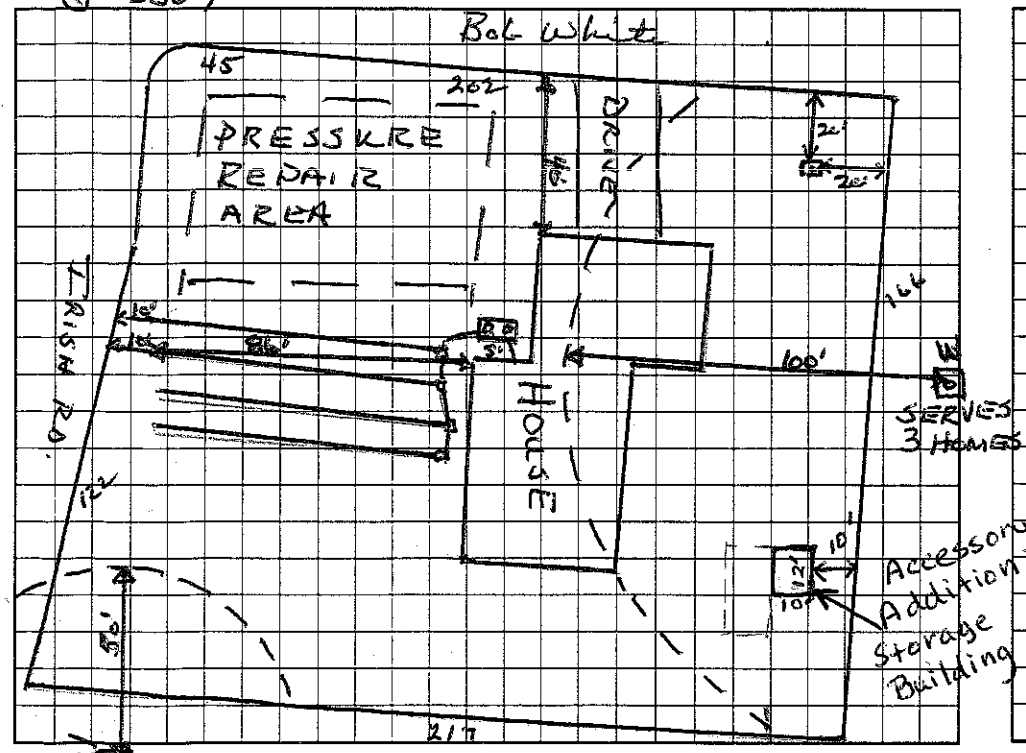

AS BUILT SKETCH

The proposed / existing Accessory Building Addition addition does not appear to impact the existing septic system.
**NOTE:

Andy Melville REHS
Date: 8-17-10
ICHD-Environmental Health Division

Permit can be suspended or revoked if any false information is supplied toward securing the permit/any unauthorized changes are made to the site/any unauthorized changes are made in the installation of the system. Improvement Permit with plat valid without expiration; Improvement Permit with site plan valid for sixty months. Authorization to Construct is valid for a period equal to that of Improvement Permit – not to exceed sixty months.

Signed: * [signature] date 11/14/01 Installed by: James Hudd Lr

Improvement Permit by: Wesley Sparks R.S. date 11/13/01 Operation Permit by: Wesley Sparks R.S. date 3/12/02

Authorization to Construct by: Wesley Sparks R.S. date 11/13/01 Existing System Inspection by: date

HEALTH DEPT. COPY: WHITE OWNER COPY (FINAL): YELLOW OWNER COPY (INITIAL): PINK