IREDELL COUNTY HEALTH DEPARTMENT 4645098754

Statesville Phone TR 3-7271 Mooresville Phone No. 664-5281

PERMIT TO INSTALL SEPTIC TANK

Permit No. _____ Permit Date 5-17-1973

Owner max wicker Address Mooresville

Installed By E. J. Ervin Address Mooresville


Location of Property out Templeton Road bear left at end of 1184 across 1185

Tank		Capacity		Length of Lines		Fixtures	
Block	( )	1000	( )	225'	( )	No. of Baths	(2)
Precast	(✓)	1250	(✓)	250'	( )	Dishwasher	(yes)
		1500	( )	Other 260'		Garbage Grdr.	(yes)
		Other				Other Washing machine	

NOTIFY HEALTH DEPARTMENT AT LEAST EIGHT HOURS BEFORE TANK IS TO BE INSPECTED.

Final Inspection 5-17-1973 Approved (✓) Disapproved ( )

Remarks

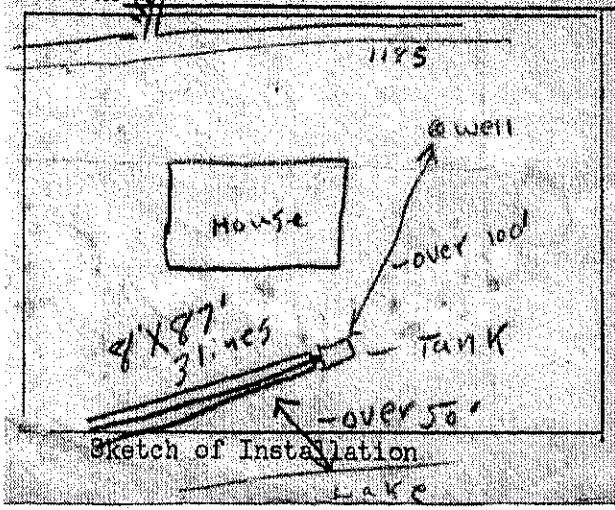

Sketch of Installation

J. C. Moore

Sanitarian