4645099282 3 of

IREDELL COUNTY HEALTH DEPARTMENT

STATESVILLE 704-878-5305 MOORESVILLE 704-664-5281

IMPROVEMENT PERMIT / CERTIFICATE OF COMPLETION / OPERATION PERMIT / EXISTING SYSTEM INSPECTION

PROPERTY DESCRIPTION NO. Repair DATE 8/12/96 TAX MAP NO. Repair Watershed: ☒ Yes ☐ No

OWNER OR CONTRACTOR Scot Henman PHONE: Business 663-0420 Home LAKE NORMAN

ADDRESS 115 Irish Rd

LOCATION 21 - TR Alcove - TR Templeton - TR Irish Rd - # 115 Irish Rd

SUBDIVISION Bob White BLOCK / SECTION ____ LOT ____ LOT AREA ____ SITE CLASS. RS DESIGN FLOW 360gpd L.T.A.R. .3gpd/ft²

Septic Tank: 1000 Gallons; STB ____ Date ____

Pump Tank: ____ Gallons; PT ____ Date ____

Pump Make: ____ Model ____ Serial No. ____

Nitrification Field: No Fields 1 Square Feet 600 Linear Feet 200

No Lines 4 Trench Width 24" Max Trench Bottom Depth 36" Gravel Depth N/A

☐ New System ☑ Repair System Type: I, II, III, IV, V, VI

System Description: ____

Repair System Description: GRAVITY PANEL

Maintenance Agreement Required: ☐ Yes ☐ No

☑ House/Mod. Home No. Bedrooms 3

☐ Mobile Home No. Bathrooms 2

☐ Business No. Employees ____

☐ Other ____


☐ Slab ☑ Crawl Space ☐ Basement w/plumbing ☐ Basement wo/plumbing

Water Supply: ☑ Individual ☐ Community ☐ Public

Comments: Tank May Need to be replaced. STAY 50' FROM NEIGHBOR'S WELL AND EXISTENT SITE WELL. BULL-RUN-VALVE SHALL BE INSTALLED

Comments:

INITIAL SITE SKETCH

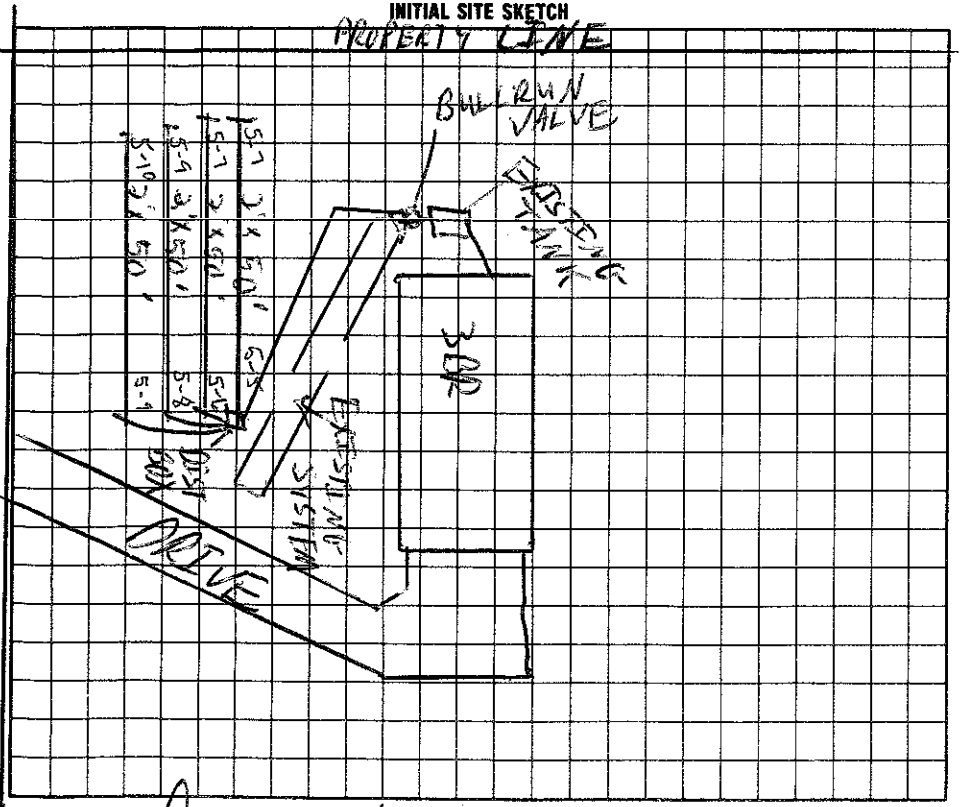

AS BUILT SKETCH

I understand that this permit can be suspended or revoked if any false information is supplied toward securing the permit/any unauthorized changes are made to the site/any unauthorized changes are made in the installation of the system.

Signed: ____

Improvement Permit by: C. Robertson EHSE date 8/12/96

Auth. to Construct

Existing System Inspection by: C. Robertson EHSE date 8/12/96

Installed by: Richard Abernathy

Certificate of Completion by: ____ date ____

Operation Permit by: Wesley Sparks RS. date 10/28/96

HEALTH DEPT. COPY: WHITE INSPECTION COPY (FINAL): GREEN OWNER COPY (FINAL): YELLOW INSPECTION COPY (INITIAL): PINK OWNER COPY (INITIAL): GOLD