IREDELL COUNTY HEALTH DEPARTMENT

STATESVILLE 704-878-5305 MOORESVILLE 704-664-5281

IMPROVEMENT PERMIT / CERTIFICATE OF COMPLETION / OPERATION PERMIT / EXISTING SYSTEM INSPECTION

PROPERTY DESCRIPTION NO. 06992 DATE 10/27/97

OWNER OR CONTRACTOR Nicholas Vida TAX MAP NO. 4645136540

ADDRESS 196 Yeoman Rd. Mooresville, NC 28115 PHONE: Business _____ Home 896-3174

LOCATION Langtree Rd. TR Yeoman Rd. to end on R # 196 Watershed: X Yes ☐ No

SUBDIVISION _____ BLOCK / SECTION _____ LOT _____ LOT AREA _____ SITE CLASS. _____ DESIGN FLOW _____ L.T.A.R. _____

Septic Tank: Existing System Gallons; ~~PT~~ _____ Date _____

Pump Tank: _____ Gallons; PT _____ Date _____

Pump Make: _____ Model _____ Serial No. _____

Nitrification Field: No Fields ___ ~~Square Feet~~ Existing System ~~Linear Feet~~ _____

No Lines _____ Trench Width _____ Max Trench Bottom Depth _____ Gravel Depth _____

☐ New System ☐ Repair System Type: I, II, III, IV, V, VI

System Description: Existing System

Repair System Description: _____

Maintenance Agreement Required: ☐ Yes X No

X House/Mod. Home No. Bedrooms 3

☐ Mobile Home No. Bathrooms ___

☐ Business No. Employees ___

☐ Other _____

☐ Slab X Crawl Space ☐ Basement w/plumbing ☐ Basement wo/plumbing


Water Supply:
X Individual
☐ Community
☐ Public

Comments:


Comments:

LN

INITIAL SITE SKETCH

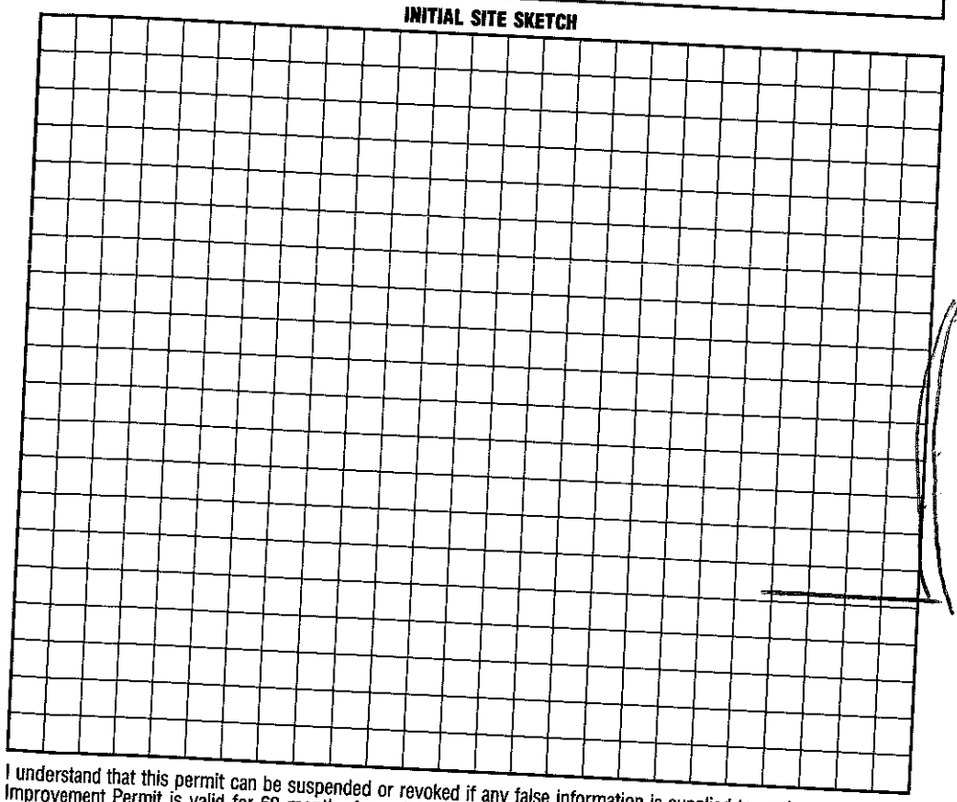

AS BUILT SKETCH

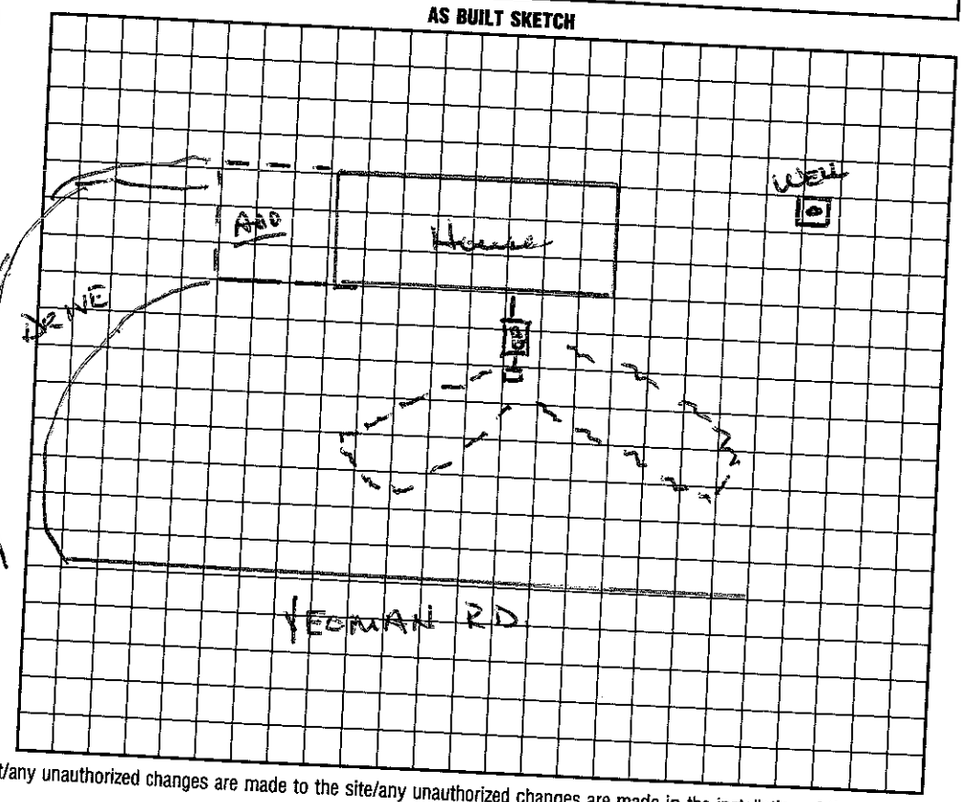

I understand that this permit can be suspended or revoked if any false information is supplied toward securing the permit/any unauthorized changes are made to the site/any unauthorized changes are made in the installation of the system. Improvement Permit is valid for 60 months from date of issuance.

Signed: _____

Improvement Permit by: _____ date _____

Existing System Inspection by: _____ date _____

Installed by: _____

Certificate of Completion by: Existing System Wesley Sparks date 10/27/97

Operation Permit by: Wesley Sparks date 10/27/97

HEALTH DEPT. COPY: WHITE INSPECTION COPY (FINAL): GREEN OWNER COPY (FINAL): YELLOW INSPECTION COPY (INITIAL): PINK OWNER COPY (INITIAL): GOLD