IREDELL COUNTY HEALTH DEPARTMENT

STATESVILLE 704-878-5305 MOORESVILLE 704-664-5281

IMPROVEMENT PERMIT / AUTHORIZATION TO CONSTRUCT / OPERATION PERMIT / EXISTING SYSTEM INSPECTION

PERMIT # 160980 PIN # 4645116157 DATE 6-2-2010

OWNER or APPLICANT Brian Mullins/Aloha Pools PHONE: Business 704 597-7171 Home: 704 660-5774

OWNER or APPLICANT ADDRESS 132 Iron Gate Cir. Mooresville NC 28117

LOCATION / DIRECTIONS Williamson Rd TL Alcove TR Templeton TL Camino Real TL Iron Gate on right

SUBDIVISION The Cove BLOCK / SECTION LOT # 5 LOT AREA 1.092Ac DESIGN FLOW 360gpd L.T.A.R.

EXIST

Septic Tank 1500 Gallons: STB Date

Pump Tank 1000 Gallons: P T Date

Pump Make Model Serial #

Nitrification Field No Fields 1 No Lines 4 Linear Feet 300

Trench Width EXIST Max. Trench Bottom Depth Gravel Depth 12"

☐ New System ☐ Repair ☐ Expansion System Type I II (III) IV V VI 3B

System Description: Exist Pump-Conventional

Repair System Description: Pump-Modified

Maintenance Agreement Required ☐ YES ☒ NO

☐ GRAVITY ☒ PRESSURE


☒ Residence No. Bedrooms 3 ☐ Business No. Persons ☐ Other No. Employees ☐ Slab ☐ Crawl Space ☐ Basement w/plumbing ☐ Basement w/o plumbing

Water Supply ☒ Private ☐ Public ☐ Community


Comments / Conditions: Existing Septic System appears to be functioning okay at time of inspection. Swimming Pool should not impact Septic System.

Comments / Conditions: Must keep Pool "cut" at least 15ft from Septic System

INITIAL SITE SKETCH

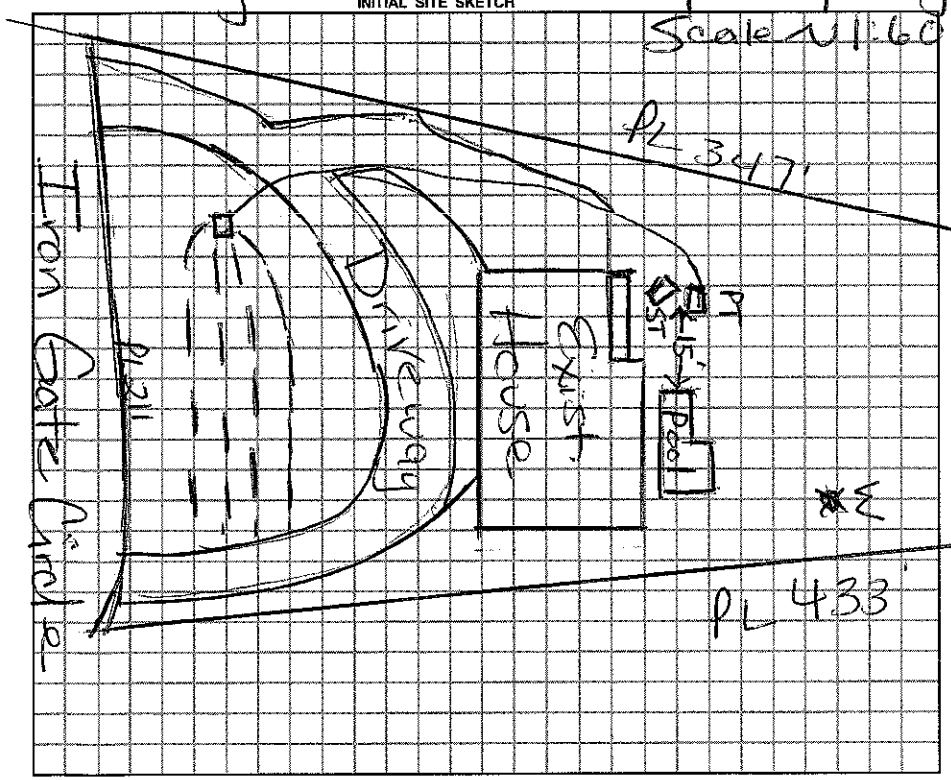

AS BUILT SKETCH

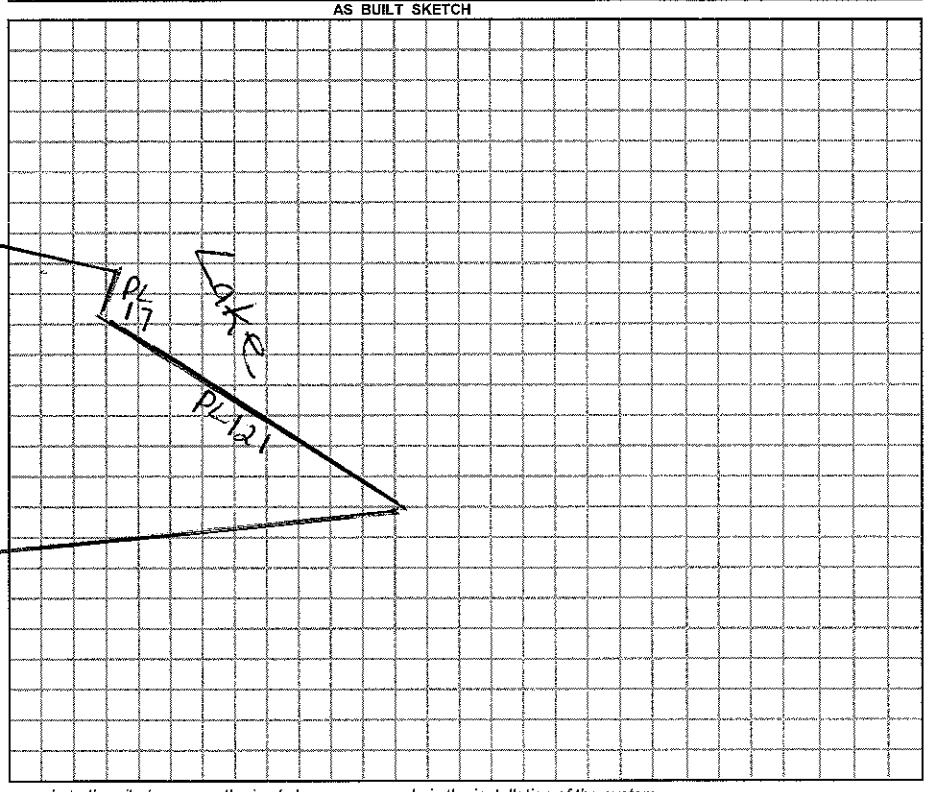

Permit can be suspended or revoked if any false information is supplied toward securing the permit / any unauthorized changes are made to the site / any unauthorized changes are made in the installation of the system.

☐ *IMPROVEMENT PERMIT w / plat valid without expiration.* ☐ *IMPROVEMENT PERMIT w / site plan valid for 60 mos.* ☐ *AUTHORIZATION TO CONSTRUCT valid for period equal to IMPROVEMENT PERMIT-not to exceed 60 mo.*

Owner / Applicant Signature: Tim Porter Aloha Pools Date 6/3/2010 Installed by: EJ Ervin

Improvement Permit by: Date

Authorzation to Construct by: Date

Operation Permit by: Date:

Existing System Inspected by: Date: REHS 6/2/2010

YOU SHOULD CONTACT A LOCATOR SERVICE PRIOR TO ANY EXCAVATION.

WHITE COPY Environmental Health YELLOW COPY (Final) Owner / Applicant PINK COPY (Initial) Owner / Applicant