IREDELL COUNTY HEALTH DEPARTMENT

STATESVILLE 704-878-5305 125.00 Paid 11:30 MOORESVILLE 704-664-5281

IMPROVEMENT PERMIT / AUTHORIZATION TO CONSTRUCT / OPERATION PERMIT / EXISTING SYSTEM INSPECTION

PERMIT# 084079 PIN# 4645 16 5717 DATE 5/5/00

OWNER OR CONTRACTOR Raymond Greco PHONE: Business 947-8855 Home

ADDRESS 12728 Cumberland Crest Dr. Huntersville, NC. 28078

LOCATION Alcove, R, Templeton (L) on Camino Real, 1/4 mile on (L)

SUBDIVISION Queens Cove BLOCK / SECTION 3 LOT 134 LOT AREA ~1.00AC SITE CLASS PS DESIGN FLOW 360 L.T.A.R. ~~3~~ 3

Septic Tank: 1000 Gallons; STB 1012 Date 12/5/00

Pump Tank: Gallons; PT Date

Pump Make: Model Serial No. 300M

Nitrification Field: No Fields 1 Square Feet 1200 Linear Feet ~~400~~

No Lines 4 Trench Width 36" Max Trench Bottom Depth 36" Gravel Depth 12"

☒ New System ☐ Repair System Type: I II III IV V VI

System Description: Gravity - Conventional

Repair System Description: Same

Maintenance Agreement Required: ☐ Yes ☒ No

☒ House/Mod. Home No. Bedrooms ~~3~~ 60

☐ Mobile Home No. Bathrooms 3

☐ Business No. Employees

☐ Other

☐ Slab ☒ Crawl Space ☐ Basement w/plumbing ☐ Basement wo/plumbing


Water Supply: ☒ Individual ☐ Public ☐ Community

Comments:/Conditions:

Comments:/Conditions: 3/13/01 Changed to 25% reduced Typ 3 drainfield material - ALWS

Tank + 3 Lines OK 5/31/01

INITIAL SITE SKETCH (1"=50')

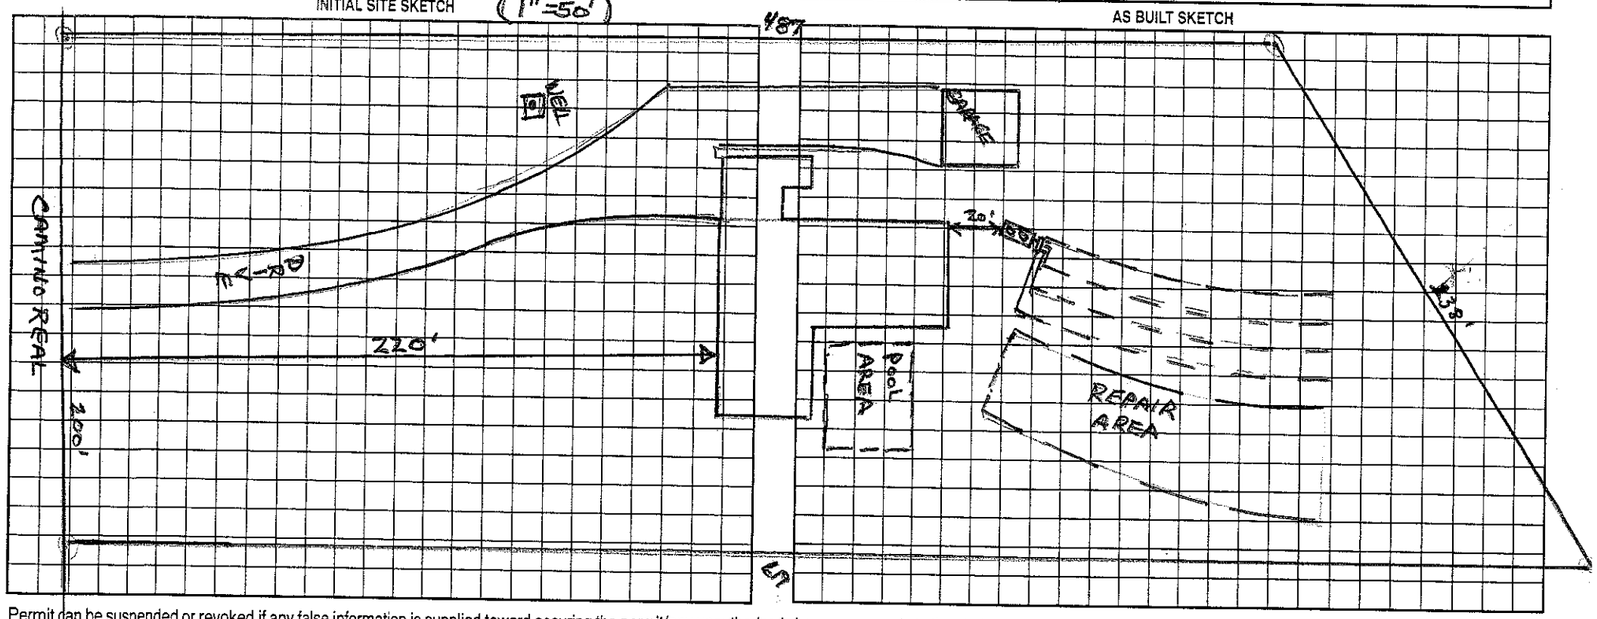

AS BUILT SKETCH

Permit can be suspended or revoked if any false information is supplied toward securing the permit/any unauthorized changes are made to the site/any unauthorized changes are made in the installation of the system. Improvement Permit with plat valid without expiration. Improvement Permit with site plan valid for sixty months. Authorization to Construct is valid for a period equal to that of Improvement Permit – not to exceed sixty months.

Signed: [signature] date 5-15-00

Improvement Permit by: Wesley Sparks RS. date 5/5/00

Authorization to Construct by: Wesley Sparks RS. date 5/5/00

Installed by: Forrest Shuford

Operation Permit by: Wesley Sparks RS. date 5/31/01

Existing System Inspection by: date

HEALTH DEPT. COPY: WHITE OWNER COPY (FINAL): YELLOW OWNER COPY (INITIAL): PINK