4645 169614

Garage/Shop addition

IREDELL COUNTY HEALTH DEPARTMENT

STATESVILLE 704-878-5305 MOORESVILLE 704-664-5281

IMPROVEMENT PERMIT / AUTHORIZATION TO CONSTRUCT / OPERATION PERMIT / EXISTING SYSTEM INSPECTION

PERMIT # 162643 PIN # 4645 16 96 14 DATE 8-24-2010

OWNER or APPLICANT Dennis Cire PHONE: Business Home:

OWNER or APPLICANT ADDRESS 132 Forum Dr. Mooresville NC 28117

LOCATION / DIRECTIONS Williamson Rd TL Alcove TR, Templeton take left @ Camino Real TL Queens Cove TR Forum Rt.

SUBDIVISION Queens Cove BLOCK / SECTION LOT # 128 LOT AREA DESIGN FLOW 1000gal L.T.A.R. .3+

Septic Tank 1000 Gallons: STB Date

Pump Tank Gallons: P T Date

Pump Make Model Serial #

Nitrification Field No Fields 1 No Lines 2 Linear Feet 100Ft

Trench Width 36" Max. Trench Bottom Depth 36" Gravel Depth N/A

☐ New System ☐ Repair ☒ Expansion System Type I II III IV V VI

System Description: Gravity -25% Reduct.

Repair System Description: Same

Maintenance Agreement Required ☐ YES ☒ NO

☒ GRAVITY ☐ PRESSURE

☐ Residence No. Bedrooms 0 ☐ Business No. Persons ☒ Other Garage w/Bath No. Employees


☐ Slab ☐ Crawl Space ☐ Basement w/plumbing ☐ Basement w/o plumbing

Water Supply: ☒ Private ☐ Public ☐ Community

Comments / Conditions: Keep Septic System at least 50Ft From Any well

Comments / Conditions

Pl-215 INITIAL SITE SKETCH

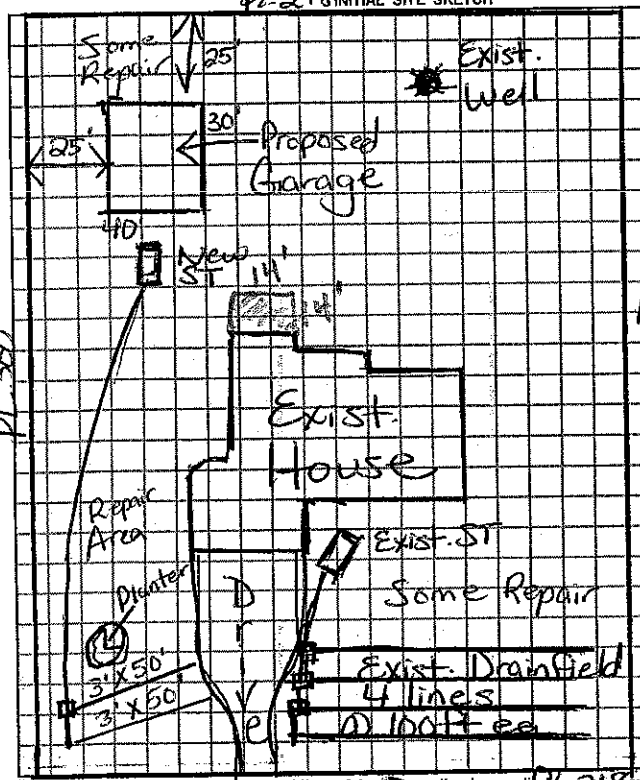

AS BUILT SKETCH

The proposed / existing Sun room addition does not appear to impact the existing septic system.

**NOTE: Must keep Building at least 5Ft From Septic Marina Dobson REHS

Date: 11/9/2010

ICHD-Environmental Health Division

Permit can be suspended or revoked if any false information is supplied toward securing the permit / any unauthorized changes are made to the site / any unauthorized changes are made in the installation of the system.

☐ IMPROVEMENT PERMIT w / site plan valid for 60 mos. ☐ IMPROVEMENT PERMIT w / plat valid without expiration. ☐ AUTHORIZATION TO CONSTRUCT valid for period equal to IMPROVEMENT PERMIT-not to exceed 60 mo.

Owner / Applicant Signature: Dennis Cire Date 9/15/10 Installed by:

Improvement Permit by: Marina Dobson REHS Date 8/24/2010 Operation Permit by: Date:

Authorization to Construct by: Marina Dobson Date 8/31/2010 Existing System Inspected by: Date:

YOU SHOULD CONTACT A LOCATOR SERVICE PRIOR TO ANY EXCAVATION.

WHITE COPY Environmental Health YELLOW COPY (Final) Owner / Applicant PINK COPY (Initial) Owner / Applicant