Garage/Shop addition

IREDELL COUNTY HEALTH DEPARTMENT

STATESVILLE 704-878-5305 MOORESVILLE 704-664-5281

IMPROVEMENT PERMIT / AUTHORIZATION TO CONSTRUCT / OPERATION PERMIT / EXISTING SYSTEM INSPECTION

PERMIT # 102643 PIN # ~~4645169614~~ 4645169614 DATE 8-24-2010

OWNER or APPLICANT Dennis Cire PHONE: Business Home:

OWNER or APPLICANT ADDRESS 132 Forum Dr. Mooresville NC 28117

LOCATION / DIRECTIONS Williamson Rd TL Alcove TR Templeton take 1st L Camino Real TL Queens Cove TR Forum Rt

SUBDIVISION Queens Cove BLOCK / SECTION LOT # 128 LOT AREA DESIGN FLOW 1000gl L.T.A.R. .37

Septic Tank 1000 Gallons: STB 312 Date 12-27-10
Pump Tank Gallons: P T Date
Pump Make Model Serial #
Nitrification Field No Fields 1 No Lines 2 Linear Feet 100 FT
Trench Width 36" Max. Trench Bottom Depth 36" Gravel Depth N/A

☐ New System ☐ Repair ☒ Expansion System Type I II III IV V VI
System Description: Gravity -25% Reduct.
Repair System Description: Same
Maintenance Agreement Required ☐ YES ☒ NO
☒ GRAVITY ☐ PRESSURE


☐ Residence No. Bedrooms 0
☐ Business No. Persons
☒ Other Garage w/Bath No. Employees
☐ Slab ☐ Crawl Space
☐ Basement w/plumbing ☐ Basement w/o plumbing

Water Supply: ☒ Private ☐ Public ☐ Community

Comments / Conditions: Keep Septic System at least 50FT From any well

Comments / Conditions: Checked ST 1/31/11 MD
Checked drainfield 3/29/11

PL 215 INITIAL SITE SKETCH

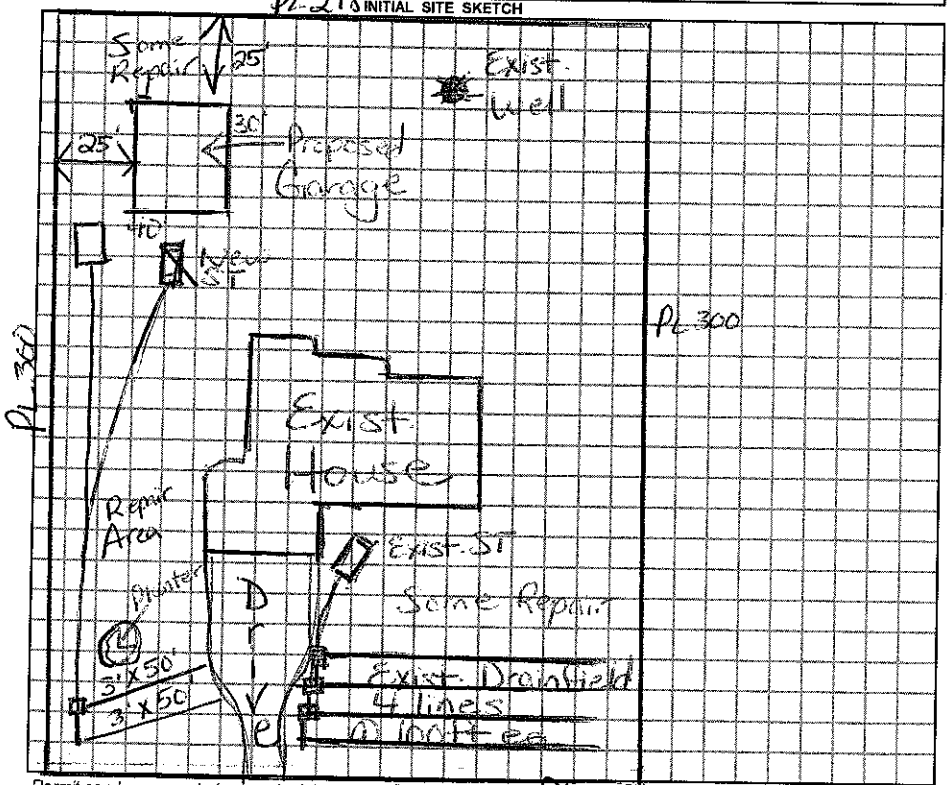

AS BUILT SKETCH

Installed Quick 4 essentially as Drawn.

Permit can be suspended or revoked if any false information is supplied toward securing the permit / any unauthorized changes are made to the site / any unauthorized changes are made in the installation of the system.

☐ *IMPROVEMENT PERMIT w / plat valid without expiration.* ☐ *IMPROVEMENT PERMIT w / site plan valid for 60 mos.* ☐ *AUTHORIZATION TO CONSTRUCT valid for period equal to IMPROVEMENT PERMIT-not to exceed 60 mo.*

Owner / Applicant Signature: Date 9/15/10

Improvement Permit by: REHS Date 8-24-2010

Authorization to Construct by: Date 8/31/2010

Installed by: L W Osbison REHS

Operation Permit by: Date 3/29/11

Existing System Inspected by: Date:

YOU SHOULD CONTACT A LOCATOR SERVICE PRIOR TO ANY EXCAVATION.

WHITE COPY Environmental Health YELLOW COPY (Final) Owner / Applicant PINK COPY (Initial) Owner / Applicant