IREDELL COUNTY HEALTH DEPARTMENT

STATESVILLE 704-878-5305 MOORESVILLE 704-664-5281

IMPROVEMENT PERMIT / AUTHORIZATION TO CONSTRUCT / OPERATION PERMIT / EXISTING SYSTEM INSPECTION

PERMIT # REPAIR PIN # 4645 18 1682 DATE 7/21/2010

OWNER or APPLICANT Richard SPEAKS PHONE: Business Home: 704-663-3604

OWNER or APPLICANT ADDRESS 127 BOB WHITE LN.

LOCATION / DIRECTIONS ALCOVE TR TEMPLETON TO LAKE (R), (R) ON BOB WHITE ~ 3 ON (R), MAILBOX ON (L)

SUBDIVISION WHITE BLOCK / SECTION ~~3~~ 36 LOT # ~~3~~ 36 LOT AREA 1.0 DESIGN FLOW 480 L.T.A.R. .3

Septic Tank 1000 Gallons: STB ~~STONE~~ 760 Date 3/30/2010
Pump Tank ____ Gallons: P T ____ Date ____
Pump Make ____ Model ____ Serial # ____
Nitrification Field No Fields ____ No Lines 7 Linear Feet EXISTING
Trench Width ____ Max. Trench Bottom Depth ____ Gravel Depth ____


☐ New System ☒ Repair ☐ Expansion System Type I (II) III IV V VI
System Description: INSTALL NEW S/T WITH FILTER
Repair System Description: AND RISER AND CONNECT
Maintenance Agreement Required ☐ YES ☐ NO
☐ GRAVITY ☐ PRESSURE

☒ Residence No. Bedrooms 4
☐ Business No. Persons ____
☐ Other No. Employees ____
☐ Slab ☐ Crawl Space
☐ Basement w/plumbing ☒ Basement w/o plumbing

Water Supply: ☒ Private ☐ Public ☐ Community

Comments / Conditions: DRAINFIELD/BED

INITIAL SITE SKETCH

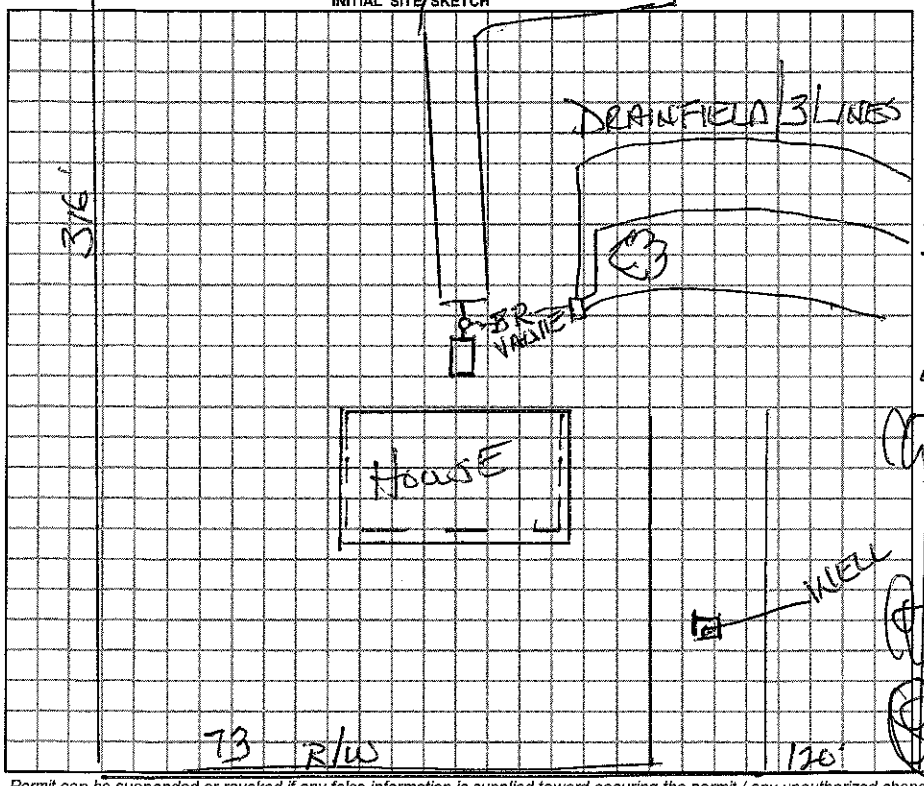

Comments / Conditions: TO EXISTING BULL RUN VALVE AND 2 DRAINFIELDS

AS BUILT SKETCH

Permit can be suspended or revoked if any false information is supplied toward securing the permit / any unauthorized changes are made to the site / any unauthorized changes are made in the installation of the system.

☐ *IMPROVEMENT PERMIT w / plat valid without expiration.* ☐ *IMPROVEMENT PERMIT w / site plan valid for 60 mos.* ☐ *AUTHORIZATION TO CONSTRUCT valid for period equal to IMPROVEMENT PERMIT-not to exceed 60 mo.*

Owner / Applicant Signature: X Dennis BOB WHITE Date 7-21-10
Improvement Permit by: Wesley Sparks REHS Date 7/21/2010
Authorization to Construct by: Wesley Sparks REHS Date 7/21/2010
YOU SHOULD CONTACT A LOCATOR SERVICE PRIOR TO ANY EXCAVATION.

Installed by: A1 Backhoe
Operation Permit by: Wesley Sparks RS Date: 7/22/2010
Existing System Inspected by: ____ Date: ____

WHITE COPY Environmental Health YELLOW COPY (Final) Owner / Applicant PINK COPY (Initial) Owner / Applicant