IREDELL COUNTY HEALTH DEPARTMENT

STATESVILLE 704-878-5305 $130 MOORESVILLE 704-664-5281

IMPROVEMENT PERMIT / AUTHORIZATION TO CONSTRUCT / OPERATION PERMIT / EXISTING SYSTEM INSPECTION

PERMIT# 115867 PIN# 4645-18-2279 DATE 10/9/03

OWNER OR CONTRACTOR Elwyn Tate PHONE: Business 704-664-0306 Home

ADDRESS 352 Templeton Rd Mooresville NC 28117

LOCATION 4/corner TR Templeton, 3rd on Rt past Henry Ln.

SUBDIVISION Bob White BLOCK / SECTION LOT 37 LOT AREA 1.06 AC SITE CLASS. PS DESIGN FLOW 480 L.T.A.R. 0.3

Septic Tank: 1000 Gallons; STB 794 Date 2-4-04
Pump Tank: 1000 Gallons; PT 27 Date 2-4-04
Pump Make: Zoeller Model N152 Serial No.
Nitrification Field: No Fields 1 Square Feet 1200 Linear Feet 400
No Lines 4@100' Trench Width 36" Max Trench Bottom Depth 36" Gravel Depth —

☒ New System ☐ Repair System Type: I, II, (III), IV, V, VI
System Description: PM -25% Reduction
Repair System Description: Same
Maintenance Agreement Required: ☐ Yes ☒ No

☒ House/Mod. Home No. Bedrooms 4
☐ Mobile Home No. Bathrooms 3
☐ Business No. Employees
☐ Other

☐ Slab ☒ Crawl Space ☐ Basement w/plumbing ☐ Basement wo/plumbing


Water Supply: ☒ Individual ☐ Public ☐ Community

Comments:/Conditions:


1"=50'

Comments:/Conditions: Pressure tanks & lines checked 5/14/04 mz

INITIAL SITE SKETCH

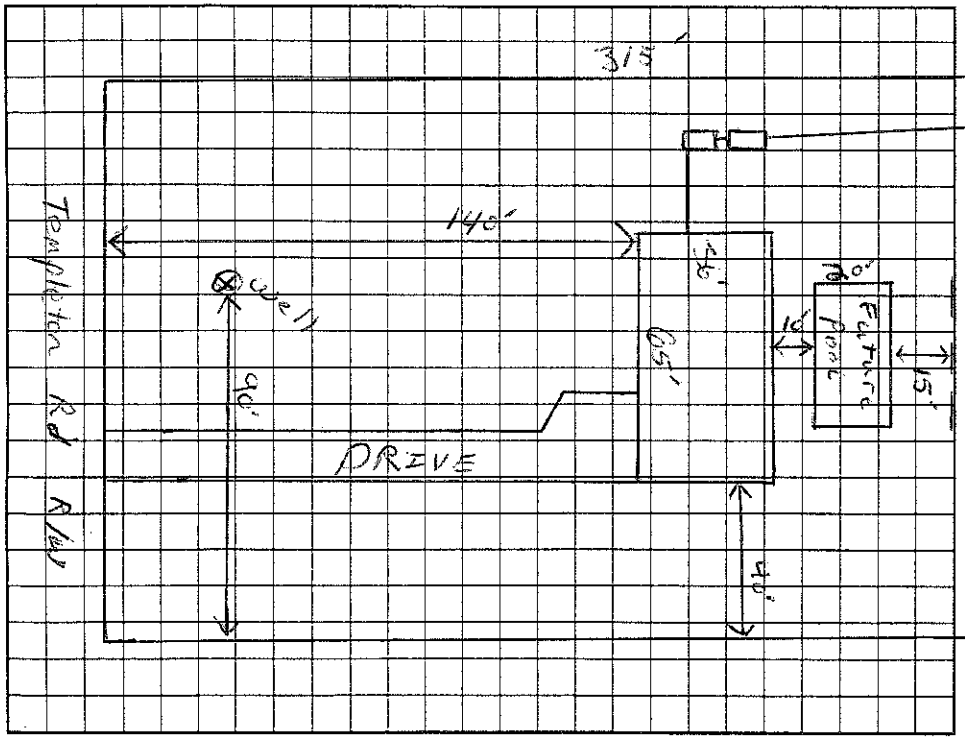

AS BUILT SKETCH

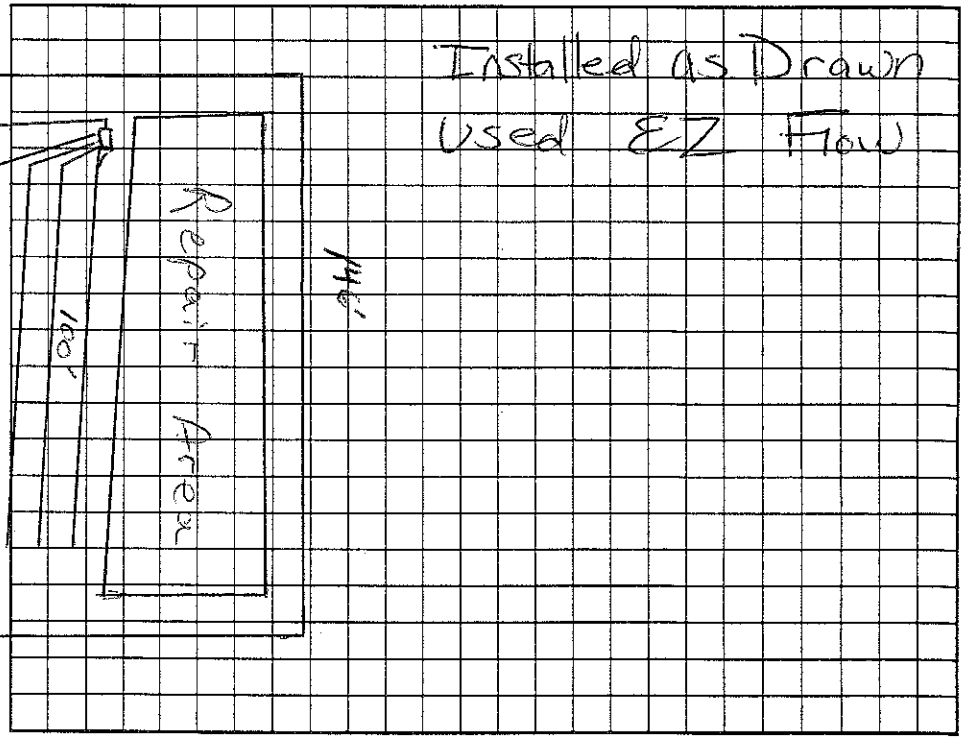

Permit can be suspended or revoked if any false information is supplied toward securing the permit/any unauthorized changes are made to the site/any unauthorized changes are made in the installation of the system. Improvement Permit with plat valid without expiration. Improvement Permit with site plan valid for sixty months. Authorization to Construct is valid for a period equal to that of Improvement Permit – not to exceed sixty months.

Signed: date 10-6-03 Installed by: Larry Beam

Improvement Permit by: RS date 10/9/03 Operation Permit by: RS date 5/11/05

Authorization to Construct by: RS date 10/9/03 Existing System Inspection by: date

HEALTH DEPT. COPY: WHITE OWNER COPY (FINAL): YELLOW OWNER COPY (INITIAL): PINK