IREDELL COUNTY HEALTH DEPARTMENT

Statesville Office (704) 878-5305 Mooresville Office (704) 660-3625 PERMIT # 180023 ✓

IMPROVEMENT PERMIT / AUTHORIZATION TO CONSTRUCT / OPERATION PERMIT / EXISTING SYSTEM

PIN # 4645 18 53 96 80

APPLICANT: Brian Stikeleather APPLICANT ADDRESS: 1013 Triple Crown Dr, Indian Trail NC 28079

SITE ADDRESS: Templeton Rd Mooresville NC 28117 PHONE: 704-622-7389 ALT. PHONE:

SITE DIRECTIONS: Alcove Rd, Rt on Templeton Rd, Lot on corner of Templeton + Henry Ln


SUBDIVISION: ~~Kelly~~ ~~Cove~~ R A White Jr SECTION: LOT # 42+43 LOT AREA: 1.37ac DESIGN FLOW: 480 L.T.A.R.: 0.3

Septic Tank	1000	(gal)	STB 94	Date 5-6-14	☑ New System	☐ Repair	☐ Expansion	System Type: I II III IV V VI	☑ Residence	No. Bedrooms 4	Water Supply
Pump Tank		(gal)	PT	Date	System Description: 25% Reduction				☐ Business	No. Persons 8	☑ Private
Pump Make		Model		Serial #	Repair System Description: 25% Reduction				☐ Other	No. Employees	☐ Public
# Nitrification Fields	1	# Lines	3	Linear Ft: 400	Maintenance Agreement Required:	☐ YES	☑ NO		☐ Slab	☑ Crawl Space	☐ Community
Trench Width	36"	Max. Trench Bottom Depth	36"	Gravel Depth		☑ GRAVITY	☐ PRESSURE		☐ Basement w/plumbing	☐ Basement w/o plumbing	


Comments / Conditions: * AC NOT TO BE ISSUED UNTIL LOTS HAVE BEEN COMBINED AND DEEDED AND RECORDED *
*LOTS COMBINED AND RECORDED 9-25-13
1"=50'

Installed Quick 4, essentially as Drawn.

INITIAL SITE SKETCH

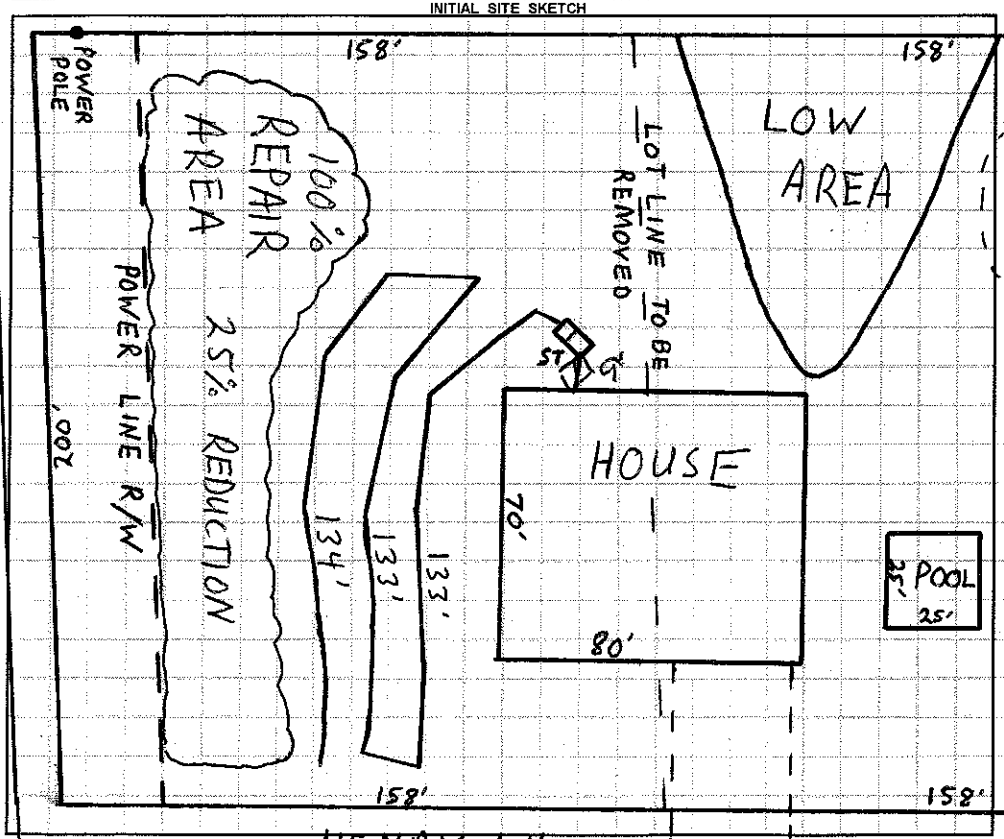

AS BUILT SKETCH

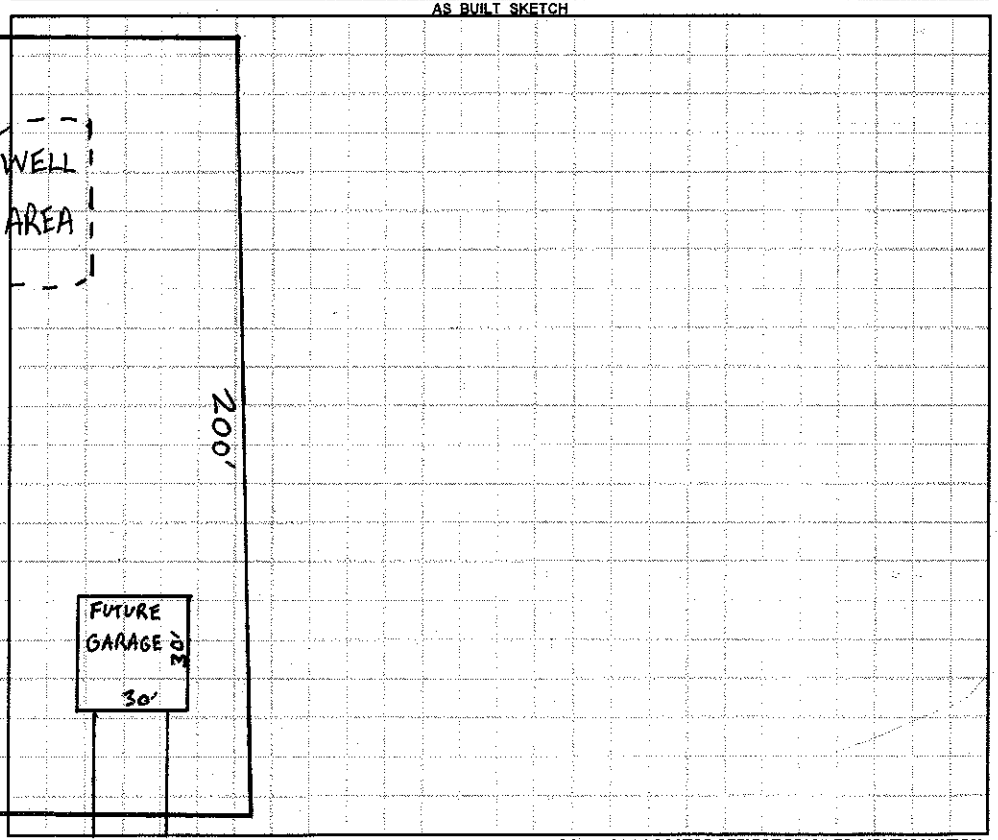

Permit can be suspended or revoked if any false information is supplied toward securing the permit / any unauthorized changes are made to the site / any unauthorized changes are made in the installation of the system. **CONTACT A LOCATOR SERVICE PRIOR TO ANY EXCAVATION**

☐ **IMPROVEMENT PERMIT** *with plat valid without expiration.* ☑ **IMPROVEMENT PERMIT** *with site plan valid for 60 mos.* ☐ **AUTHORIZATION TO CONSTRUCT** *valid for period equal to IMPROVEMENT PERMIT--not to exceed 60 mo.*

Owner / Applicant Signature: Date: 9-25-13 Installed by: Stevens Septic Service

IMPROVEMENT PERMIT by: Date: 9-11-13 OPERATION PERMIT by: Date: 6/9/14

AUTHORIZATION TO CONSTRUCT by: Date: 9-25-13 Existing System Inspected by: Date:

Health Dept. Copy - WHITE Applicant (Final Approval) - YELLOW Applicant (Conditional Approval) - PINK