IREDELL COUNTY HEALTH DEPARTMENT

STATESVILLE 704-878-5305 MOORESVILLE 704-664-5281

IMPROVEMENT PERMIT / AUTHORIZATION TO CONSTRUCT / OPERATION PERMIT / EXISTING SYSTEM INSPECTION

PERMIT# Repair PIN# ? 4645-18-5987 TONEY JACOBS DATE 9/15/03

OWNER OR CONTRACTOR Ronald Talbot PHONE: Business 663-6905 Home

ADDRESS 120 Henry Ln. Mooresville, NC. 28117

LOCATION Above TR Templeton. TR Henry Ln. on (L) just past Bob White Ln # 120

SUBDIVISION Kelly Cove BLOCK / SECTION LOT 4 LOT AREA 2.67AC SITE CLASS. PS DESIGN FLOW 360 L.T.A.R.

Septic Tank: EXISTING Gallons: STB Date

Pump Tank: Gallons: PT Date

Pump Make: Model Serial No.

Nitrification Field: No Fields 1 Square Feet 900 Linear Feet 300

No Lines 6@50' Trench Width 3' Max Trench Bottom Depth 3' Gravel Depth No

☐ New System ☒ Repair System Type: I, II, (III), IV, V, VI

System Description: Bull Run-D/B-INFILTRATOR

Repair System Description:

Maintenance Agreement Required: ☐ Yes ☒ No

☒ House/Mod. Home No. Bedrooms 3

☐ Mobile Home No. Bathrooms 3

☐ Business No. Employees

☐ Other


☐ Slab ☐ Crawl Space ☐ Basement w/plumbing ☐ Basement wo/plumbing

Water Supply: ☒ Individual ☐ Public ☐ Community


Comments:/Conditions: Install all Bull Run Valves and new D/B on street side of sidewalk. Install 6 lines on center between the existing trenches

Comments:/Conditions: Bull Run Valves installed and placed into existing sewer Repair Main lines. Some difficulty with original D/B boarding, adjusted closer as possible. 1 Break in sidewalk between 3rd and 4th lines.

EXISTING NEW INITIAL SITE SKETCH

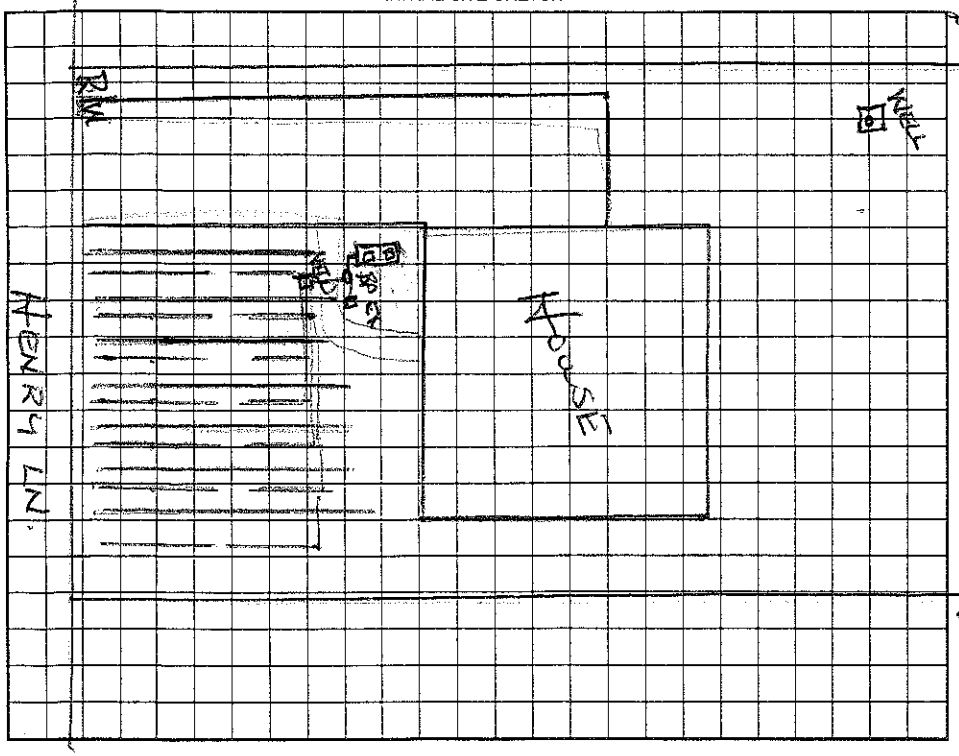

AS BUILT SKETCH

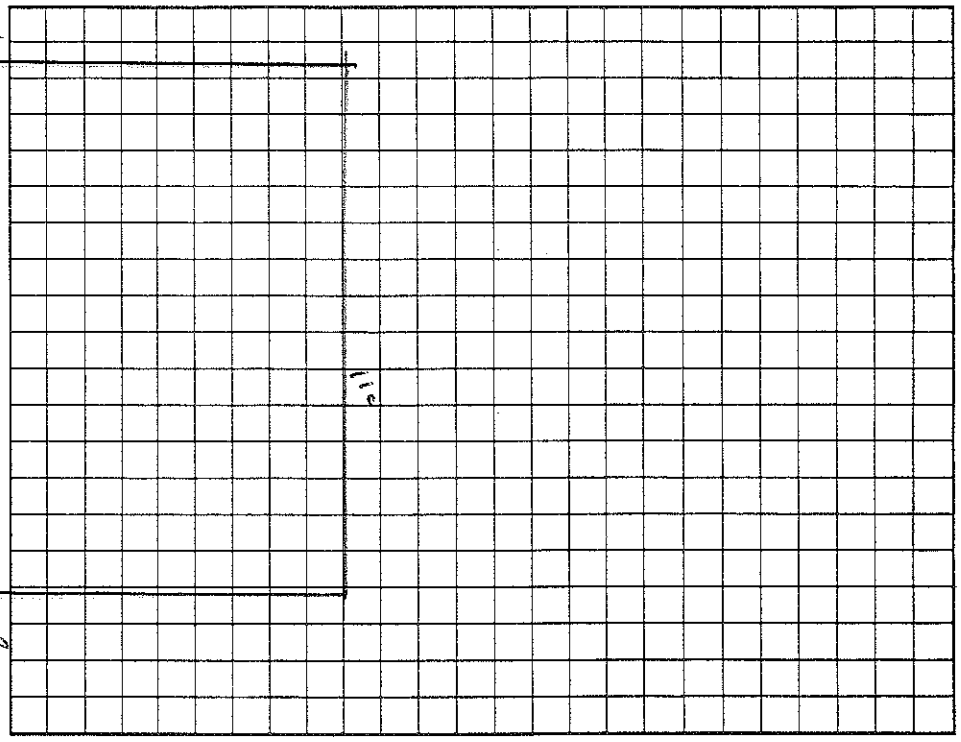

Permit can be suspended or revoked if any false information is supplied toward securing the permit/any unauthorized changes are made to the site/any unauthorized changes are made in the installation of the system. Improvement Permit with plat valid without expiration. Improvement Permit with site plan valid for sixty months. Authorization to Construct is valid for a period equal to that of Improvement Permit – not to exceed sixty months.

Signed: X [signature] date 9-16-03 Installed by: R+H

Improvement Permit by: Wesley Sparks RS date 9/15/03 Operation Permit by: Wesley Sparks RS. date 10/3/03

Authorization to Construct by: Wesley Sparks RS date 9/15/03 Existing System Inspection by: date

HEALTH DEPT. COPY: WHITE OWNER COPY (FINAL): YELLOW OWNER COPY (INITIAL): PINK

IREDELL COUNTY HEALTH DEPARTMENT

STATESVILLE 704-878-5305 MOORESVILLE 704-664-5281

IMPROVEMENT PERMIT / CERTIFICATE OF COMPLETION / OPERATION PERMIT / EXISTING SYSTEM INSPECTIO.

1/0-10 30

PROPERTY DESCRIPTION NO. 18926 DATE Aug 15, '94 TAX MAP NO 2G4A14 Watershed: ☑ Yes ☐ No

OWNER OR CONTRACTOR Ronald Talbott PHONE: Business 896-9701 Home LN

ADDRESS PO Box 1573, Davidson, NC

LOCATION 1296 (Alcove) TR 1108 (Templeton) TR Henry Lane (gravel) ~500-1000' on left

SUBDIVISION Kelly Cove BLOCK / SECTION LOT 14 LOT AREA 110 X 265 SITE CLASS B DESIGN FLOW L.T.A.R. .3

Septic Tank: 1000 Gallons; STB 797 Date 9/5/95

Pump Tank: Gallons; PT Date

Pump Make: Model Serial No. 300 AWS

Nitrification Field: No. Fields 1 Square Feet 1200 Linear Feet ~~270~~

No Lines ~~4~~ 5 Trench Width 24" Max Trench Bottom Depth 36" Gravel Depth NA

☑ New System ☐ Repair System Type: I, II, III, IV, V, VI

System Description: ~~gravity PPBPS~~ INFILTRATOR

Repair System Description: gravity & LP PPBPS

Maintenance Agreement Required: ☐ Yes ☑ No

☑ House/Mod. Home No. Bedrooms ~~2~~ 3

☐ Mobile Home No. Bathrooms 3½

☐ Business No. Employees

☐ Other

☐ Slab ☑ Crawl Space ☐ Basement w/plumbing ☐ Basement wo/plumbing


Water Supply: ☑ Individual ☐ Community ☐ Public

Comments: Exit plumbing at grade (existing)

Changes approved 8/22/95 AWS

Comments:

INITIAL SITE SKETCH

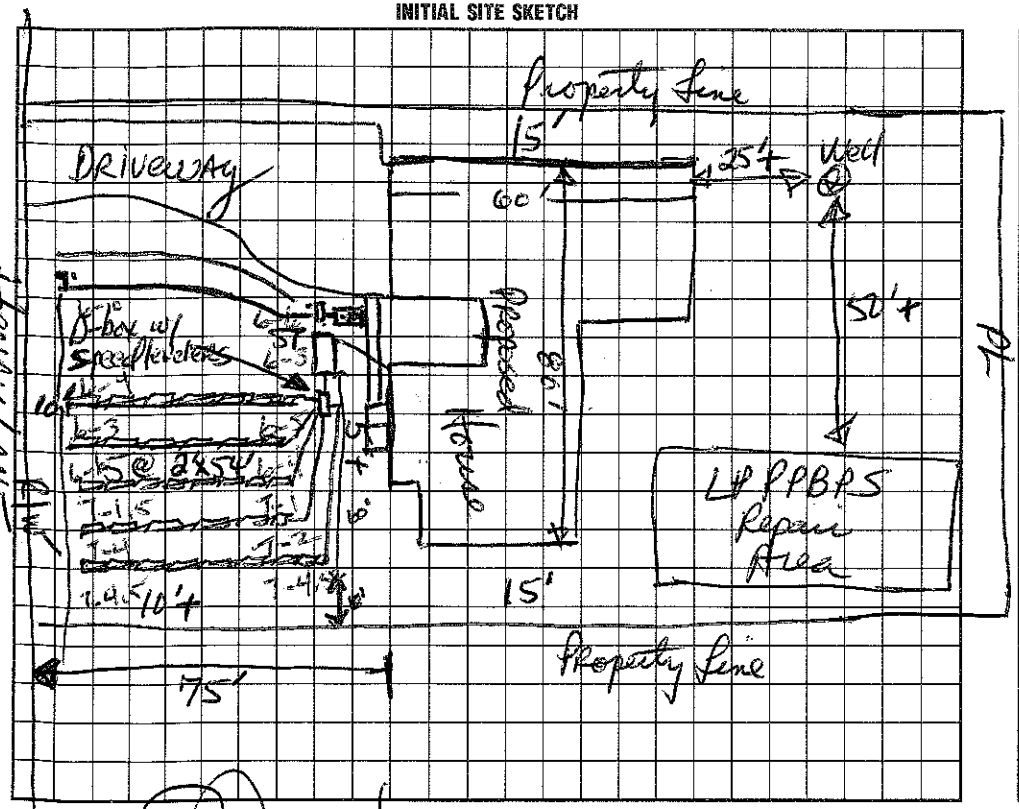

AS BUILT SKETCH

I understand that this permit can be suspended or revoked if any false information is supplied toward securing the permit/any unauthorized changes are made to the site/any unauthorized changes are made in the installation of the system. Improvement Permit is valid for 60 months from date of issuance.

Signed:

Improvement Permit by: date 8/15/94

Existing System Inspection by: date

Installed by: Brad Russell Const.

Certificate of Completion by: ~~Prior to Construct~~ Wesley Sparks RS date 10/19/95

Operation Permit by: Wesley Sparks RS. date 10/19/95

HEALTH DEPT. COPY: WHITE INSPECTION COPY (FINAL): GREEN OWNER COPY (FINAL): YELLOW INSPECTION COPY (INITIAL): PINK OWNER COPY (INITIAL): GOLD