IREDELL COUNTY HEALTH DEPARTMENT

STATESVILLE 704-878-5305 MOORESVILLE 704-664-5281

4645-18-6618

COPY

IMPROVEMENT PERMIT / CERTIFICATE OF COMPLETION / OPERATION PERMIT / EXISTING SYSTEM INSPECTION

PROPERTY DESCRIPTION NO. 20239 DATE 2/14/95 TAX MAP NO. 26-4-D-11 Watershed: ☑ Yes ☐ No N-CA

OWNER OR CONTRACTOR Barry Pederson PHONE: Business _____ Home 892-3363

ADDRESS PO Box 22165 Cornelius, NC, 28031

LOCATION Alcove Rd. TR Templeton Rd. TR Chesmut TR Bob White Dr. to intersection lot on R. Corner

SUBDIVISION Bob White BLOCK / SECTION _____ LOT 40 LOT AREA ~1.70 AC SITE CLASS. P DESIGN FLOW 360 L.T.A.R. .3-.35

Septic Tank: 1000 Gallons; STB 794 Date 5/15/96

Pump Tank: _____ Gallons; PT _____ Date _____

Pump Make: _____ Model _____ Serial No. _____

Nitrification Field: No Fields 1 Square Feet 1200 Linear Feet 400

No Lines 4 Trench Width 36" Max Trench Bottom Depth 32" Gravel Depth 12"

☑ New System ☐ Repair System Type: I, II, III, IV, V, VI

System Description: CONV - DIST BOX

Repair System Description: _____

Maintenance Agreement Required: ☐ Yes ☑ No

☑ House/Mod. Home No. Bedrooms 3

☐ Mobile Home No. Bathrooms 2.5

☐ Business No. Employees _____

☐ Other _____


☑ Slab ☐ Crawl Space ☐ Basement w/plumbing ☐ Basement wo/plumbing

Water Supply: ☑ Individual ☐ Community ☐ Public

Comments: Lines on slope contour in direction shown, 32" Max. trench depth.

Comments:

INITIAL SITE SKETCH

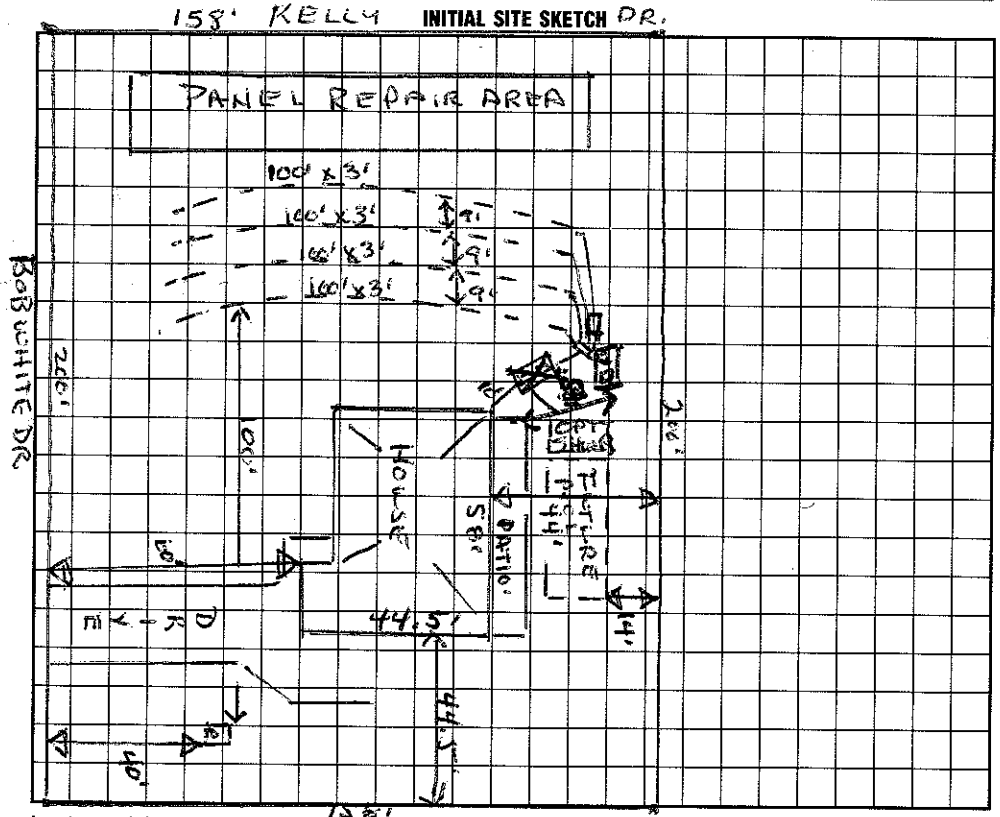

AS BUILT SKETCH

I understand that this permit can be suspended or revoked if any false information is supplied toward securing the permit/any unauthorized changes are made to the site/any unauthorized changes are made in the installation of the system. Improvement Permit is valid for 60 months from date of issuance.

Signed: _____

Improvement Permit by: Wesley Sparks R.S. date 2/14/95

Existing System Inspection by: _____ date _____

Installed by: Dobson Const.

Certificate of Completion by: _____ date _____

Operation Permit by: Wesley Sparks R.S. date 7/29/96

HEALTH DEPT. COPY: WHITE INSPECTION COPY (FINAL): GREEN OWNER COPY (FINAL): YELLOW INSPECTION COPY (INITIAL): PINK OWNER COPY (INITIAL): GOLD